
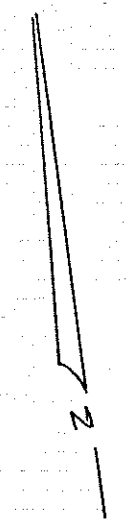


⊙ (M4) Rim Elev. 376.54 taken from Site Plan (Assumed correct)

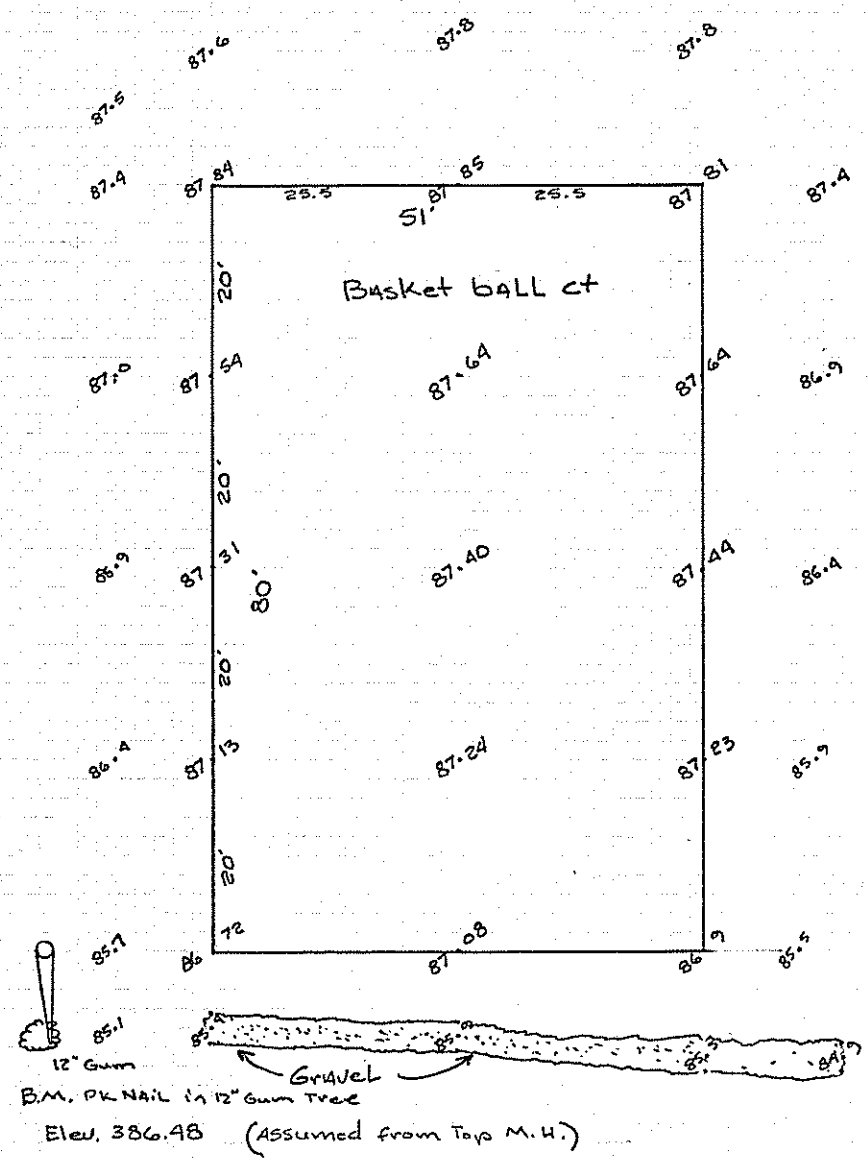

FLOWER VALLEY N.P.
ASBUILT TOPO TENNIS & BASKETBALL CT.
 SCALE 1"=20'08-23-93 D.B. M.M. M.L.