


Parcel B  
Hamlet North  
P.B. 78 - 7901  
L 3843 - F 4281

Washington Square  
Parcel A  
P.B. 51 - 3324

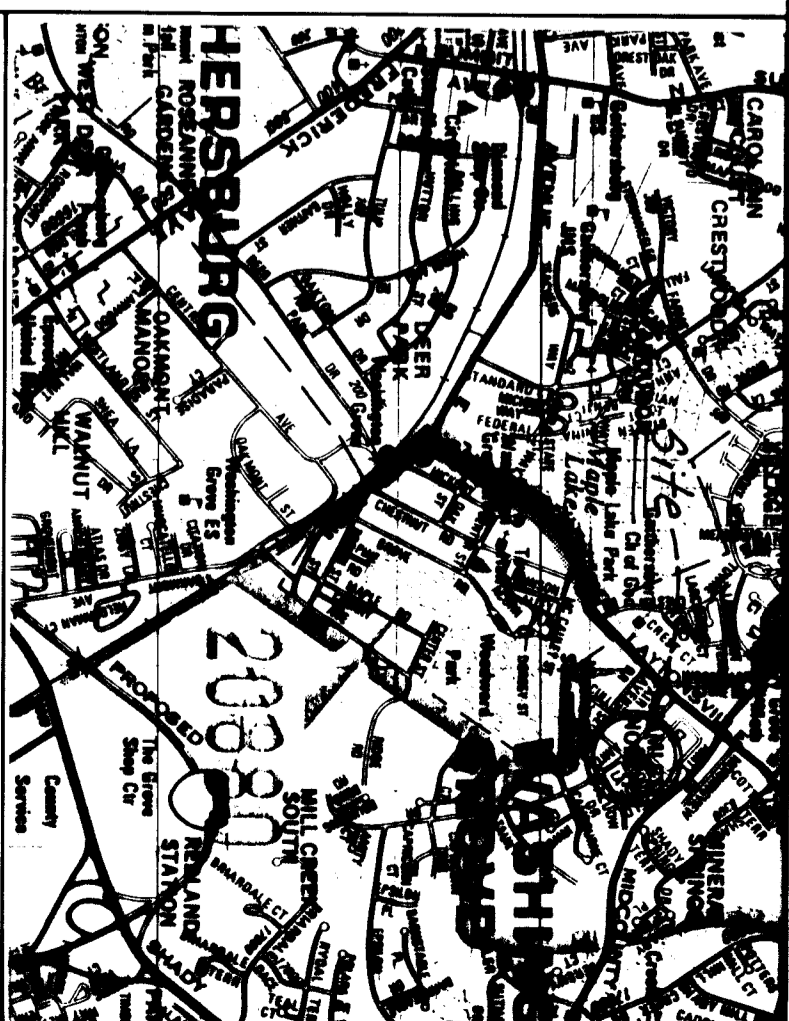

NSPC DRAWN

LAYTONVILLE ROAD  
MD. RTE. 124  
N 44°15'03\"/>

AMITY DRIVE

**NOTES:**  
Not to be used for Construction  
Lot corners have not been set by this survey unless otherwise indicated.  
Boundary Line Information shown hereon provided by MNCPPA and were not determined by this survey.

**Bench Mark Information:**  
BM 4577-A, Brass Bolt  
Washer in Conc. Headwall  
on N Side of Rte. 124  
100 ± S. of Town Crest Dr.  
Elev. 508.276  
**Bench Mark Set:**  
Concrete Monument at edge of Laytonville Road  
Elev. 532.74 PK Wall Set.  
Concrete Monument SE Property Corner  
Elev. 508.95 PK Nail Set.

<b>PLAT OF TOPOGRAPHIC SURVEY</b> <b>WASHINGTON SQUARE</b> <b>NEIGHBORHOOD PARK</b> (Washington Square) Election District Montgomery County, Maryland	
PREPARED BY DATE: 7/23/02 DRAWN: 9/27/02 PRINTED: 10/02/02	CHECKED BY DATE: 7/23/02 DRAWN: 9/27/02 PRINTED: 10/02/02
DRAWN BY DATE: 7/23/02 CHECKED BY: [Signature] TITLE NO. 42433-0	ENGINEER & PLANNERS & SURVEYORS 14101 AMETHYST ROAD • AMETHYST, MARYLAND 20725 JOB NO. MD 15316 FILE NO. 42433

