
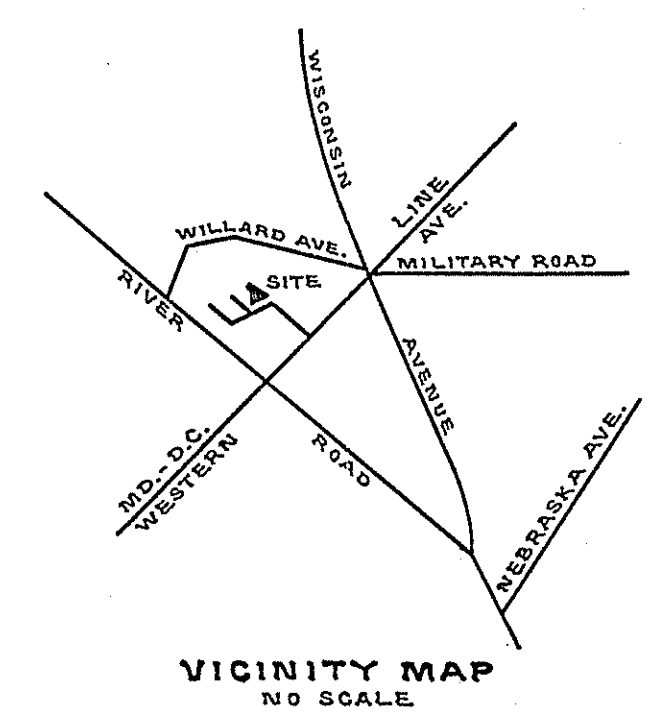
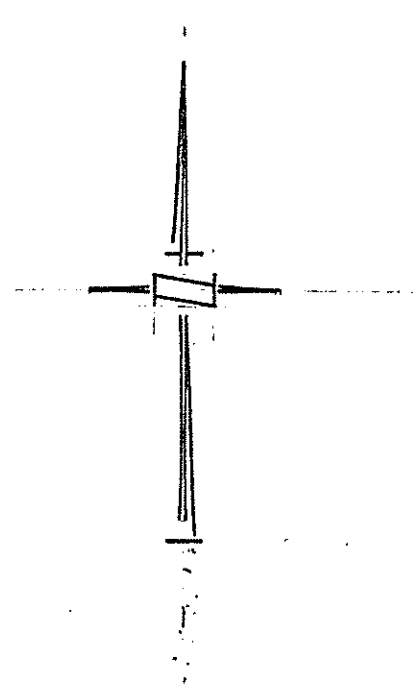


SURVEYOR'S CERTIFICATE

I hereby certify that the plan shown hereon is correct.

Date June 4, 1979

R.K. Maddox
R.K. MADDOX, L.S., MD. REG. # 528

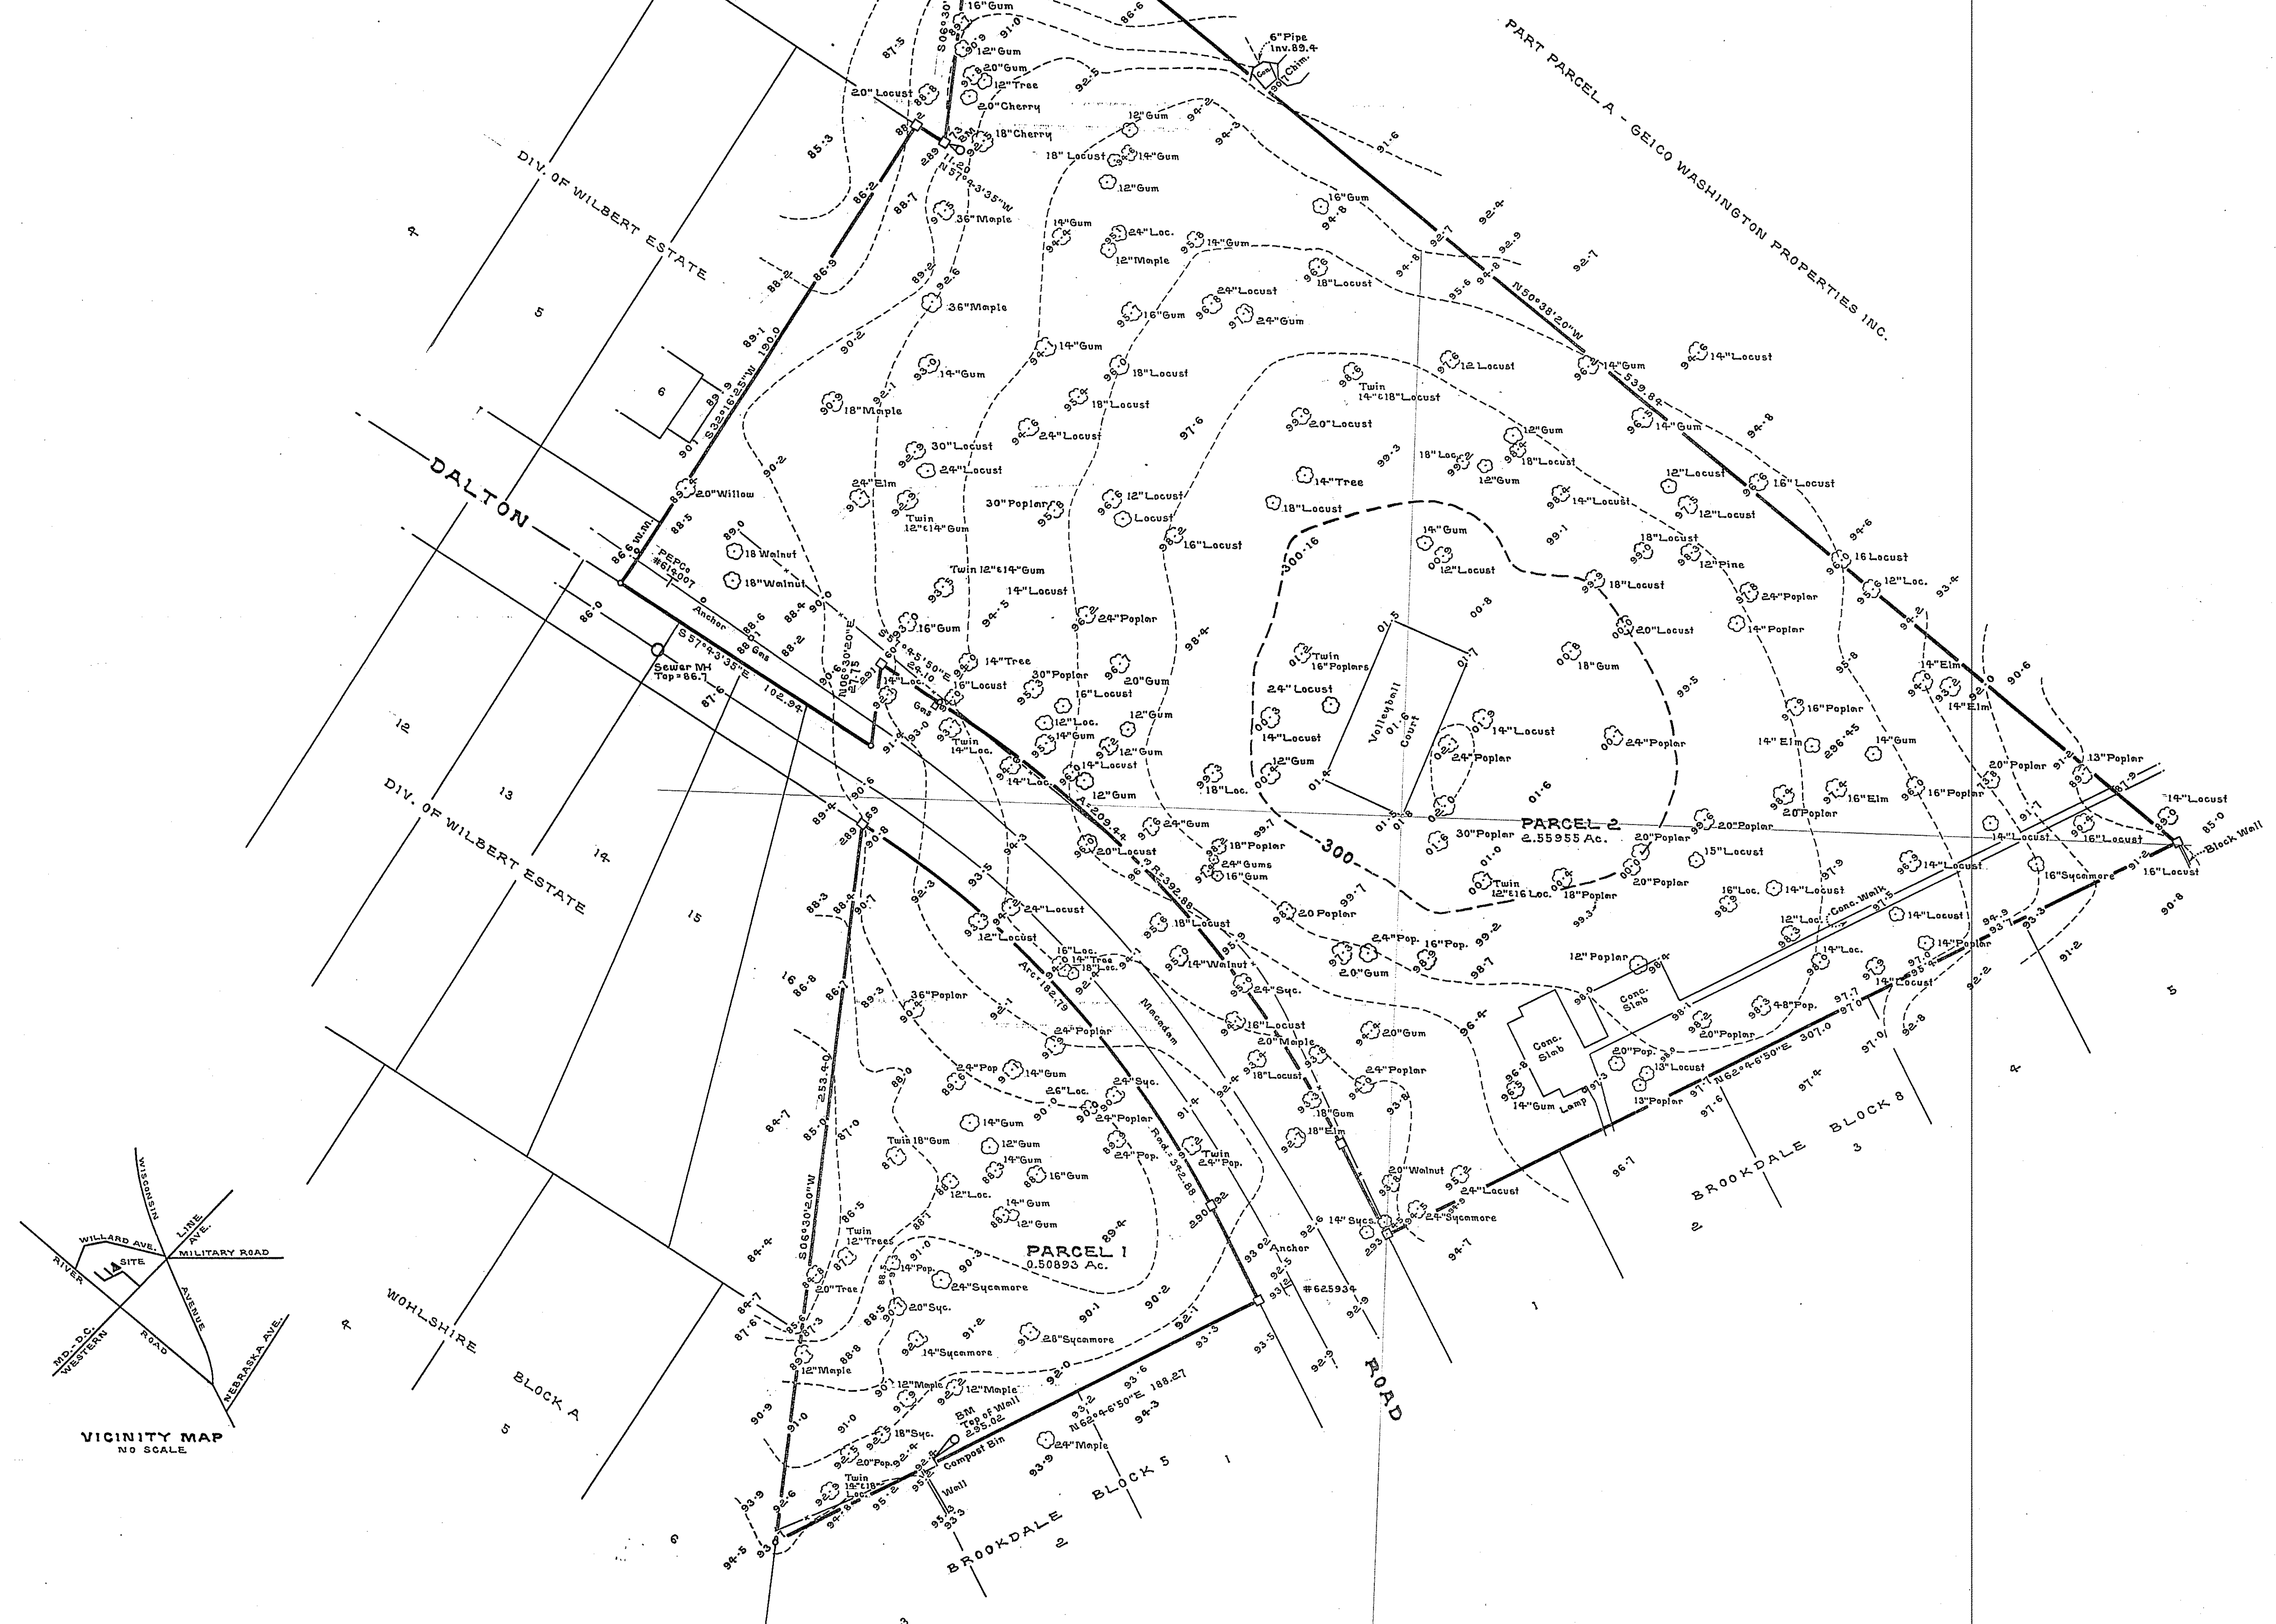

DATE	REVISION	DATE	REVISION	Prepared by R.K. MADDOX Surveyor, PLS 528 Rockville, Maryland	MARYLAND - NATIONAL CAPITAL PARK AND PLANNING COMMISSION	DRAWN	S.S.	TOPOGRAPHIC SURVEY BROOKDALE NEIGHBORHOOD PARK BETHESDA ELECTION DISTRICT NO 7 MONTGOMERY COUNTY, MARYLAND	DATE	May, 1979
						CHECKED	R.K.M.		FILE NO	
						APP. BY	M.N.C.P. & P.C.		SHEET NO	1 of 1
						SCALE	1" = 30'		DWG. NO	