


| | | |
|---|-----------------------------|---------|
| design | <i>H. H.</i> | 7-30-79 |
| landscape architect | | date |
| architect | <i>Tawabir & Jalali</i> | 7-30-79 |
| engineer | <i>John L. Aidun</i> | 7/30/79 |
| draft | | date |
| review and approval | <i>Tawabir & Jalali</i> | 7-30-79 |
| assistant division chief of engineering | | date |
| <i>Hans Barnes</i> | | 7-30-79 |
| assistant division chief of design | | date |
| <i>Joseph F. Konda</i> | | 7/30/79 |
| chief of engineering and design | | date |
| associate director of parks | | date |
| deputy director of parks | | date |
| <i>Stanley J. Zent</i> | | 7/30/79 |
| director of parks | | date |
| montgomery county planning board | | date |
| review and comment | | date |
| | | date |
| | | date |
project

Brookdale Neighborhood Park

The Maryland-National Capital Park and Planning Commission
8787 georgia avenue
silver spring, maryland 20907

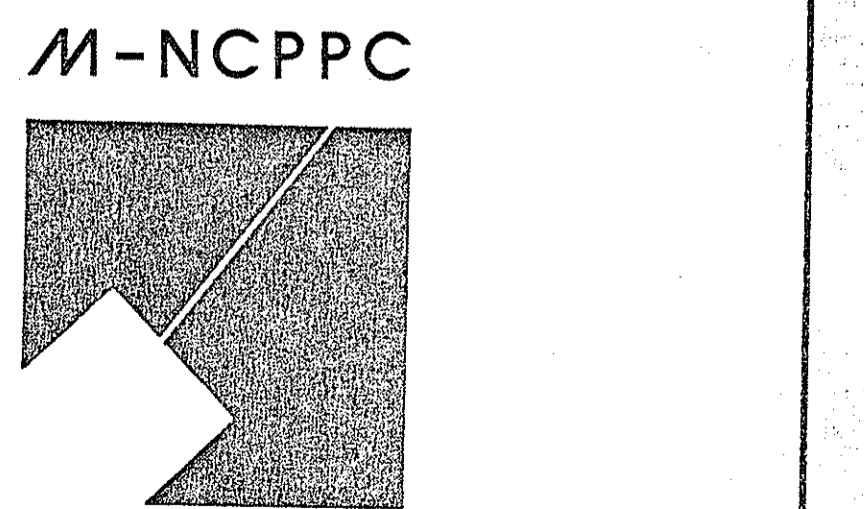

dept. of parks
montgomery co
(301) 565-7420

Engineering and Design Division
Parkside Headquarters
9500 brunett avenue
silver spring, maryland 20901

scale: AS SHOWN