


06-15

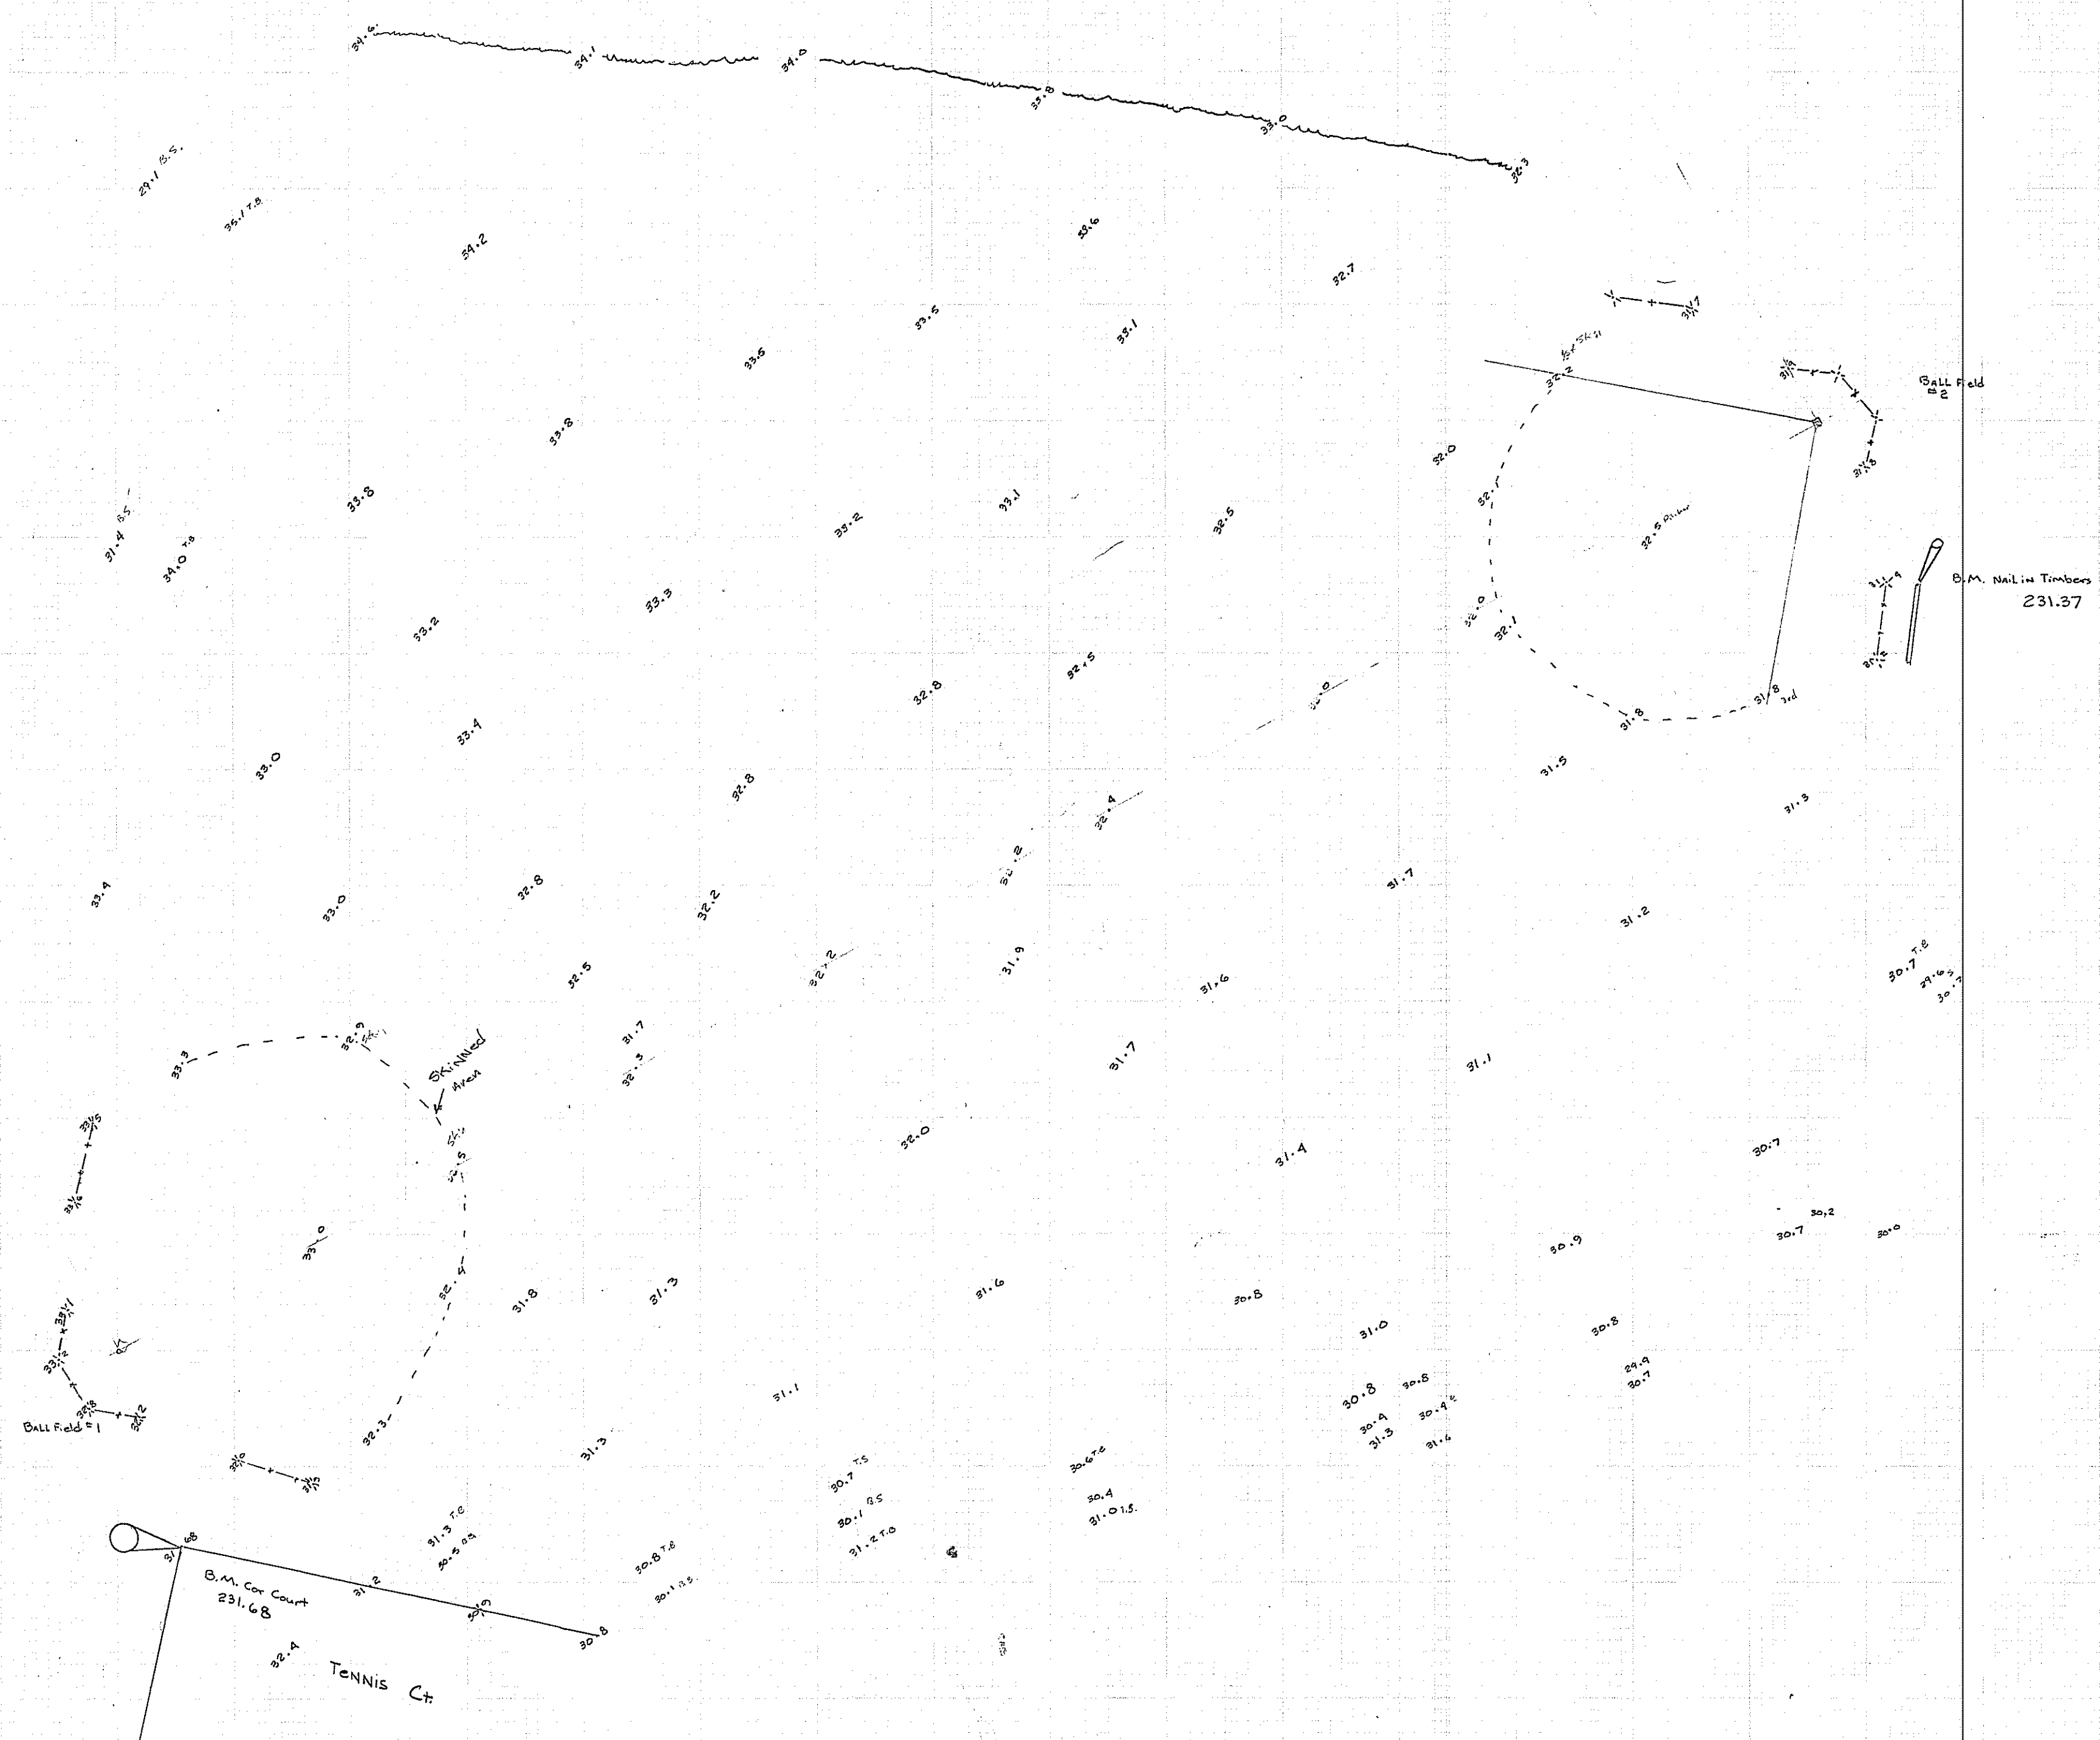

Burning Tree L.P.  
 Topo BALL Fields #1 & #2  
 Scale 1"=30' 06-18-93 M.L.M.M.S.