


Lot 30 Bk 1

Lot 30 Bk 1
Seneca Valley Estates
Scale 1"=50' 3-4-91

54°

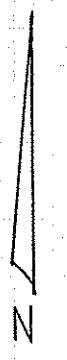

1

45.12

43.00

100
77.20

#3A

#3

#4

3-6

S 12-22-02-W
120.1

Stake #2

S 51-13-05-W
69.76

Stake #1

S 76-08-18-E
84.38

New car

S 45-52-12-W
278.0

A #1