


John Di Frick
7.30.05

FB-05
7-03-05
7/21/05

SEWER TRENCH DETAIL
NOTE: SCALE 1/8" = 1'-0" (IF NOT INDICATED)

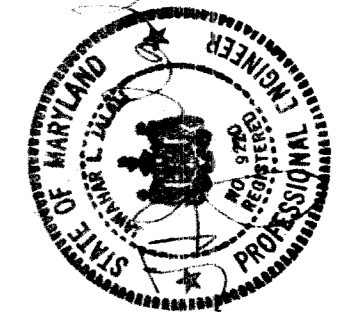

design
 ENGINEER ARCHITECT
 DATE: 7/21/05
 SIGNATURE: *John Di Frick*
 TITLE: *PE*

review and approval
 Chief of engineering and design
 Director of Parks
 MONTGOMERY COUNTY PLANNING BOARD
 DATE: _____
 SIGNATURE: _____
 TITLE: _____

review and comment
 DATE: 7/21/05
 SIGNATURE: _____
 TITLE: _____

The Maryland-National Capital Park and Planning Commission
 8787 Georgia Avenue
 Silver Spring, Maryland 20907
 dept. of parks/montgomery co.
 (301) 565-7420



scale: as shown

project:

ROCKWOOD SPECIAL PARK
 ON-SITE 6" SEWER PLAN
 "AS BUILT"

85 OS 0121