


SURVEYOR'S CERTIFICATE

I hereby certify that the property shown hereon has been accurately surveyed and that property markers have been found or set as indicated.

Joseph M. Cutsail, Jr.
 Joseph M. Cutsail, Jr.
 Reg. Land Surveyor
 Maryland No. 3624

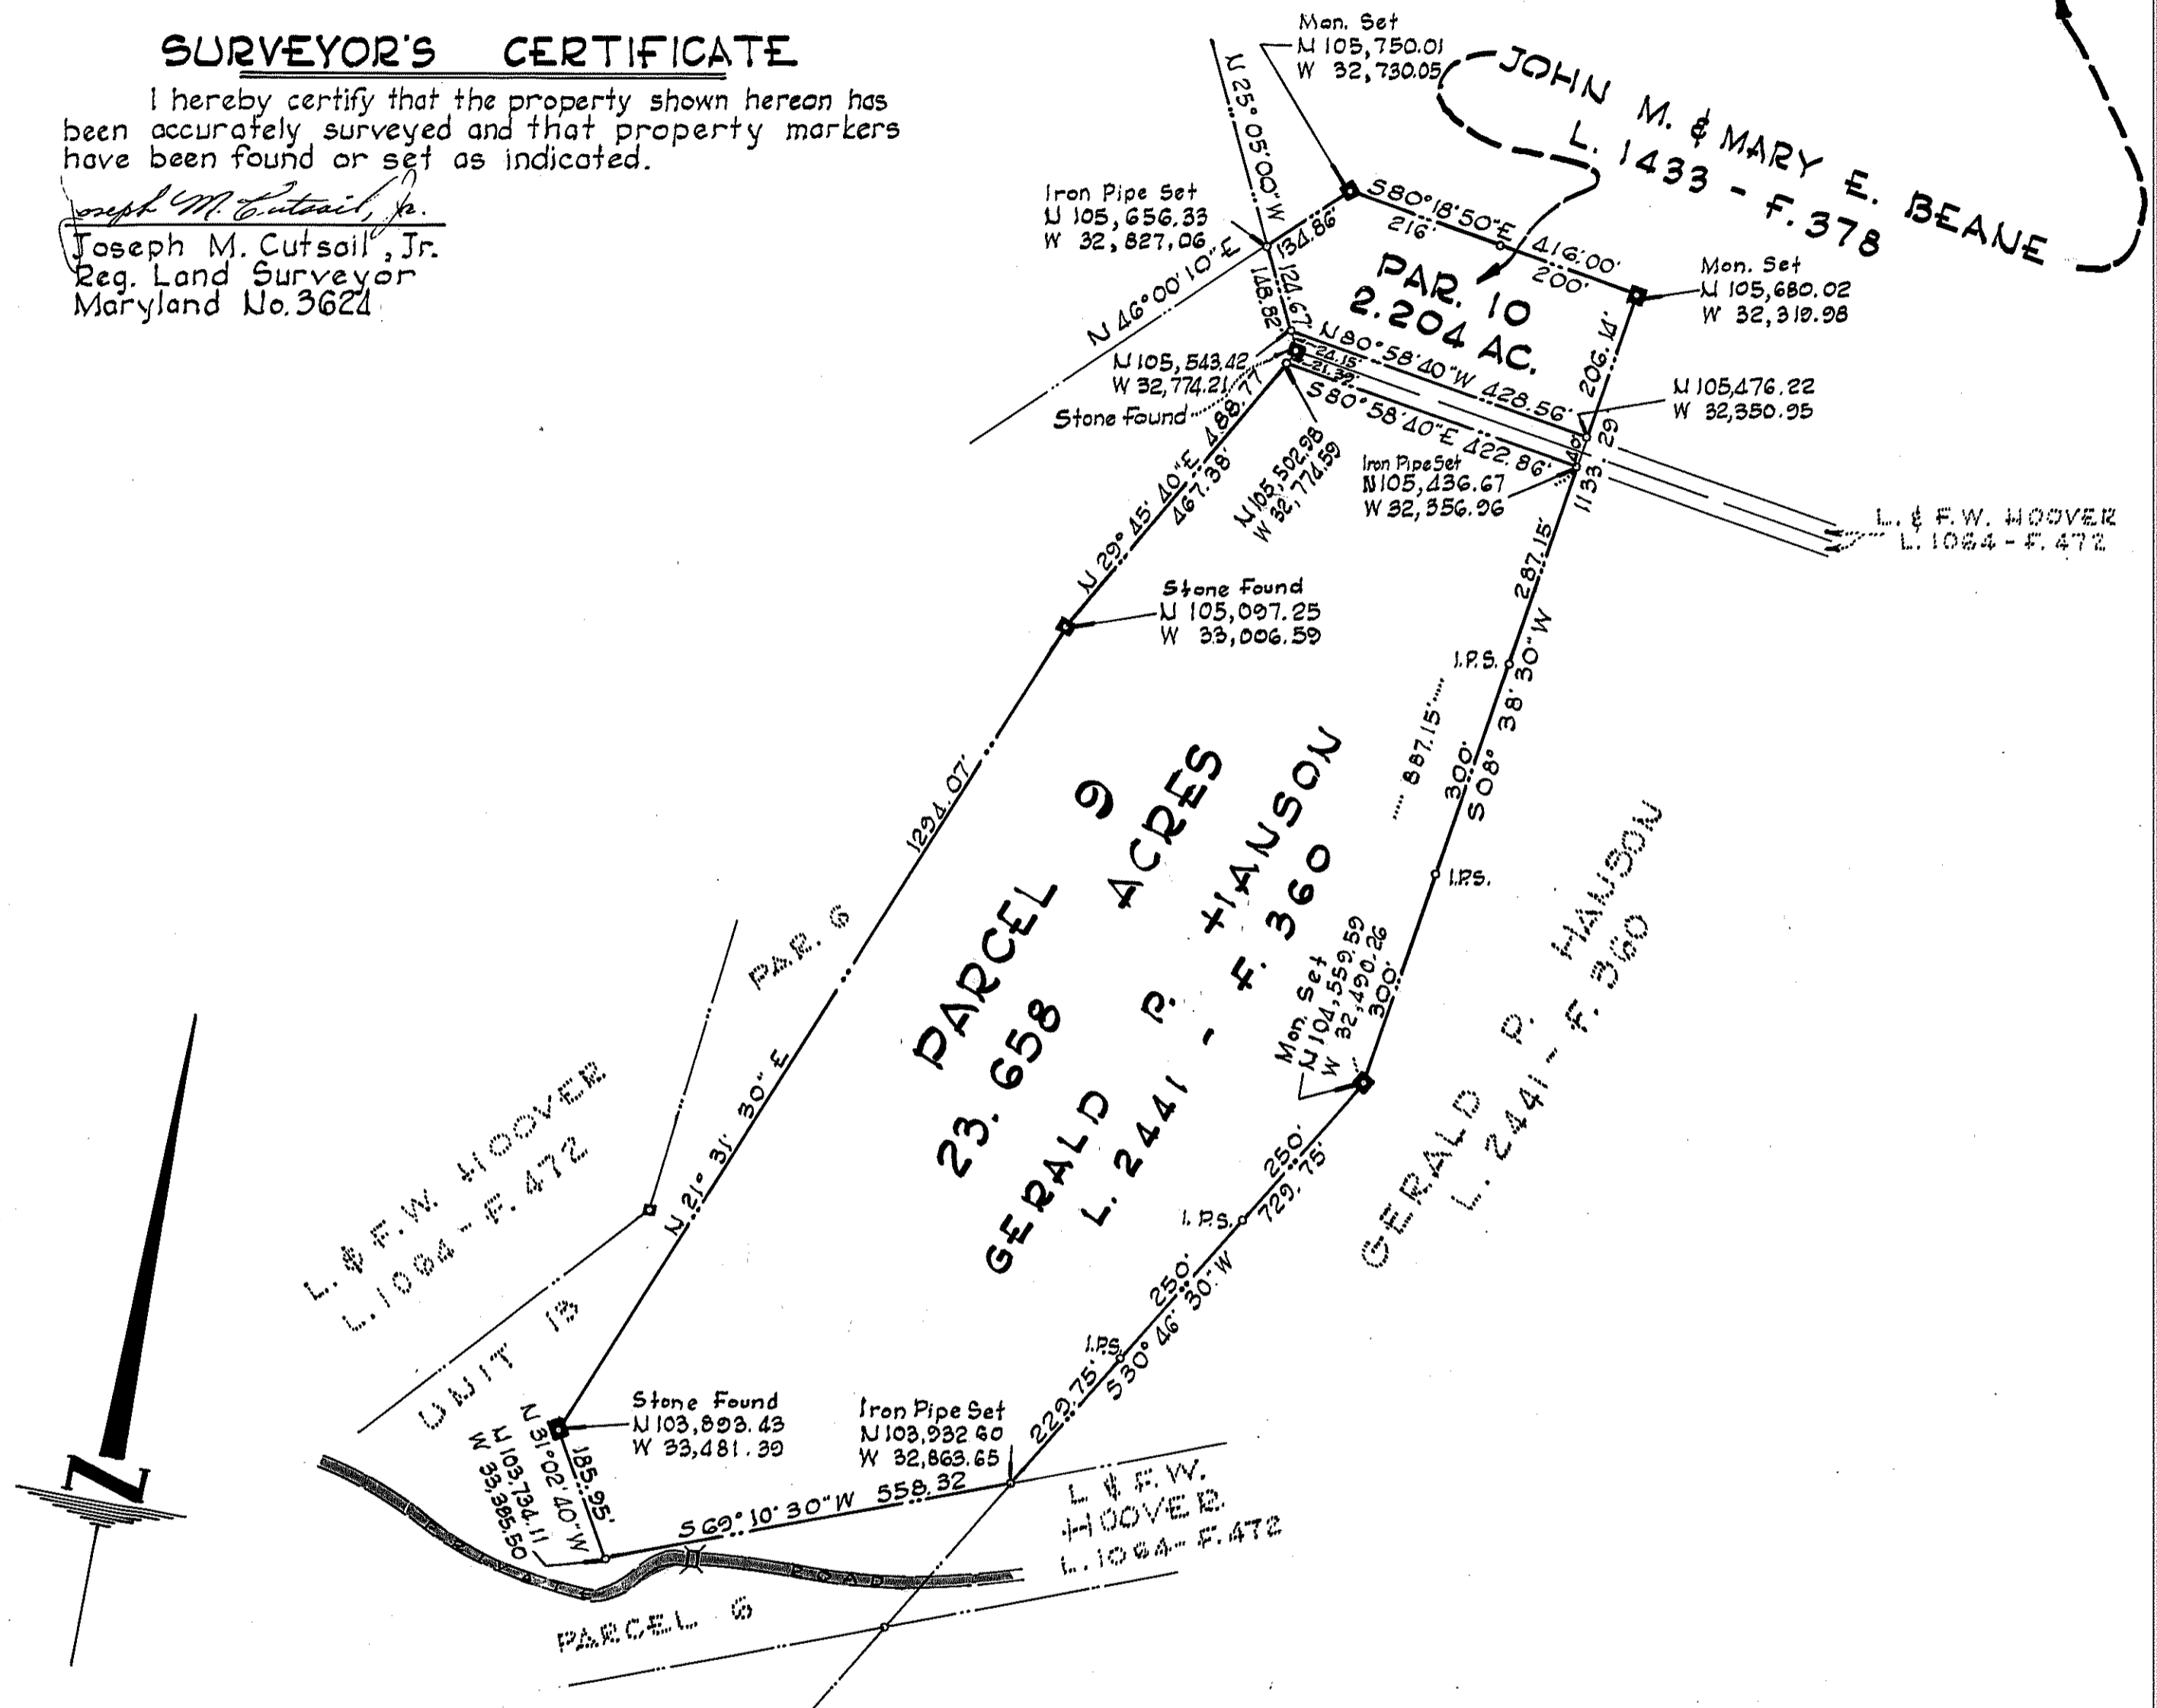

PLAT OF SURVEY
~~PARCEL 9 & 10~~
UPPER ROCK CREEK WATERSHED
~~UNIT 13~~

MONTGOMERY COUNTY, MARYLAND
 SCALE: 1" = 200' MARCH 1965
 MATZ, CHILDS & ASSOCIATES
 CIVIL ENGINEERS - LAND SURVEYORS
 322 NORTH STONE STREET AVE.
 ROCKVILLE, MARYLAND
 PO 2-5533

DEPARTMENT OF PARKS
 MARYLAND NATIONAL CAPITOL PARK & PLANNING COMMISSION

UNIT 13 - PARCELS 9 & 10 64-0602