



HISTORIC PRESERVATION COMMISSION

Marc Elrich
County Executive

Robert K. Sutton
Chairman

Date: July 20, 2021

MEMORANDUM

TO: Mitra Pedoeem
Department of Permitting Services

FROM: Dan Bruechert
Historic Preservation Section
Maryland-National Capital Park & Planning Commission

SUBJECT: Historic Area Work Permit # 955412 - Window Replacement

The Montgomery County Historic Preservation Commission (HPC) has reviewed the attached application for a Historic Area Work Permit (HAWP). This application was **approved** at the July 14, 2021 HPC meeting.

The HPC staff has reviewed and stamped the attached construction drawings.


THE BUILDING PERMIT FOR THIS PROJECT SHALL BE ISSUED CONDITIONAL UPON ADHERENCE TO THE ABOVE APPROVED HAWP CONDITIONS AND MAY REQUIRE APPROVAL BY DPS OR ANOTHER LOCAL OFFICE BEFORE WORK CAN BEGIN.

Applicant: Paul Berman & Laura Dickinson
Address: 24 Hesketh St., Chevy Chase

This HAWP approval is subject to the general condition that the applicant will obtain all other applicable Montgomery County or local government agency permits. After the issuance of these permits, the applicant must contact this Historic Preservation Office if any changes to the approved plan are made. Once work is complete the applicant will contact Dan Bruechert at 301.563.3400 or dan.bruechert@montgomeryplanning.org to schedule a follow-up site visit.



WINDOW SIZE MARK-UP - 2021.06.25

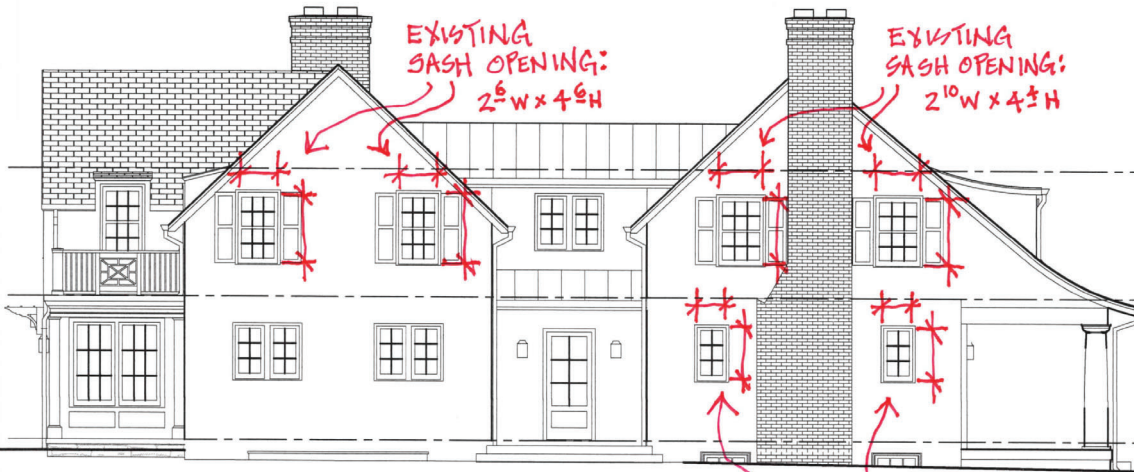

A EXISTING EAST (LEFT SIDE)
1/8" = 1'-0"

APPROVED
Montgomery County
Historic Preservation Commission


Ronald H. Butler



REVIEWED

By Dan.Bruechert at 4:44 pm, Jul 20, 2021

B PROPOSED EAST - OPTION 1
1/8" = 1'-0"

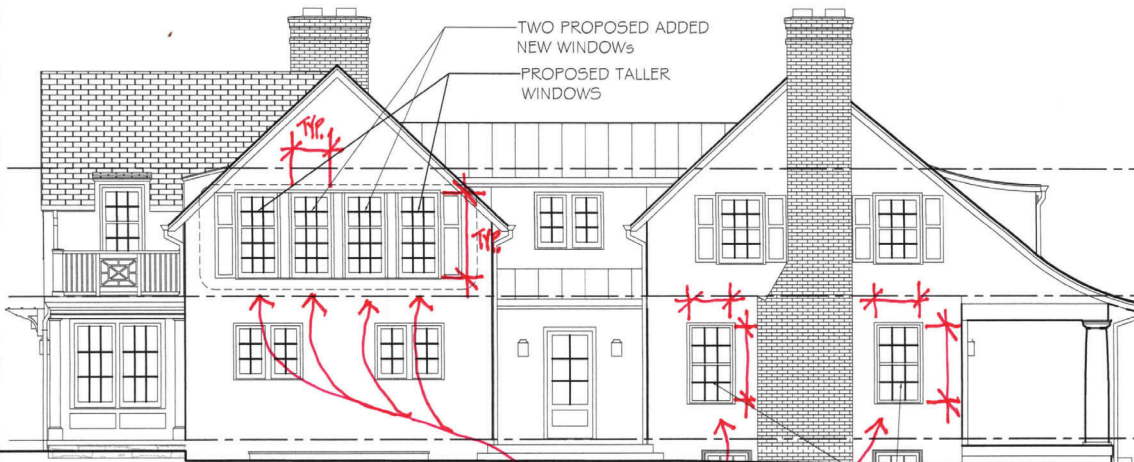

C PROPOSED EAST - OPTION #2
1/8" = 1'-0"

PROPOSED SASH OPENING: 2⁶ W x 5⁶ H

PROPOSED SASH OPENING: 2¹⁰ W x 5⁰ H

OF
2

BERMAN / DICKINSON
24 HESKETH STREET
CHEVY CHASE, MD 20815

HAWP APP
EAST SIDE WINDOWS
SCALE NOTED
2021.06.07

TREACY & EAGLEBURGER
ARCHITECTS
2737 MACOMB STREET, NW WASHINGTON, DC 20008
WWW.TREACYEAGLEBURGER.COM 202-362-5229