



HISTORIC PRESERVATION COMMISSION

Marc Elrich
County Executive

Karen Burditt
Chair

October 29, 2025

MEMORANDUM

TO: Rabbiah Sabbakhan
Department of Permitting Services

FROM: Laura DiPasquale
Historic Preservation Section
Maryland-National Capital Park & Planning Commission

SUBJECT: Historic Area Work Permit #1111377– Window replacement

The Montgomery County Historic Preservation Commission (HPC) has reviewed the attached applications for a Historic Area Work Permit (HAWP). This application was **approved with one (1) condition** at the October 8, 2025 HPC meeting:

1. The applicants must submit revised specifications and/or keyed elevation photographs correctly identifying the line of windows to be used, which should be consistent across a given elevation prior to final approval of the HAWP.

The HPC staff has reviewed and stamped the attached submission materials.

THE BUILDING PERMIT FOR THIS PROJECT SHALL BE ISSUED CONDITIONAL UPON ADHERENCE TO THE ABOVE APPROVED HAWP CONDITIONS AND MAY REQUIRE APPROVAL BY DPS OR ANOTHER LOCAL OFFICE BEFORE WORK CAN BEGIN.

Applicant: Allison Giles; Jennifer Goon, Agent
Address: 14 Hesketh Street, Chevy Chase

This HAWP approval is subject to the general condition that the applicant will obtain all other applicable Montgomery County or local government agency permits. After the issuance of these permits, the applicant must contact this Historic Preservation Office if any changes to the approved plan are made. Once work is complete, the applicant will contact Laura DiPasquale at 301-495-2167 or laura.dipasquale@montgomeryplanning.org to schedule a follow-up site visit.



Description of Property: Please describe the building and surrounding environment. Include information on significant structures, landscape features, or other significant features of the property:

PT 17 CHEVY CHASE SE
Single Family house

Description of Work Proposed: Please give an overview of the work to be undertaken:

Alco will install 26 Insert Replacement windows. The windows on the front of the home (14 Windows) that are visible from the street will be Marvin Signature. The Marvin Signature windows are Wood Interior/ Aluminum Clad exterior. The other windows on the side and rear of the home will be Marvin Elevate windows. Marvin Elevate windows are Wood interior/ Fiberglass exterior. The new windows will be white to match the existing windows and will have 7/8" Simulated divided light grids in patterns to match what is on the home. As this is an insert replacement job, all existing exterior trim will remain. All windows will be the same style as the windows that they are replacing.

REVIEWED

By Laura DiPasquale at 2:45 pm, Oct 29, 2025

APPROVED

Montgomery County

Historic Preservation Commission



Work Item 1: Windows

Description of Current Condition:

Deteriorating

Proposed Work:

Alco will install 26 Insert Replacement windows. The windows on the front of the home (14 Windows) that are visible from the street will be Marvin Signature. The Marvin Signature windows are Wood Interior/ Aluminum Clad exterior. The other windows on the side and rear of the home will be Marvin Elevate windows. Marvin Elevate windows are Wood interior/ Fiberglass exterior. The new windows will be white to match the existing windows and will have 7/8" Simulated divided light grids in patterns to match what is on the home. As this is an insert replacement job, all existing exterior trim will remain. All windows will be the same style as the windows that they are replacing.

Work Item 2: _____

Description of Current Condition:

REVIEWED

By Laura DiPasquale at 2:45 pm, Oct 29, 2025

Proposed Work:

APPROVED

Montgomery County

Historic Preservation Commission

Karen Benoit

Work Item 3: _____

Description of Current Condition:

Proposed Work:



4921 Wyconda Road
Rockville, MD 20852

301-593-1691
alcoproductsinc.com

THE EXTERIOR HOME EXPERTS → EST. 1956

Project Description

Address: 14 Hekseth St Chevy Chase, MD 20815

Homeowner: Allison Giles

26

Alco will install ~~23~~ Insert Replacement windows. The windows on the front of the home (14 Windows) that are visible from the street will be Marvin Signature. The Marvin Signature windows are Wood Interior/ Aluminum Clad exterior. The other ¹²~~9~~ windows on the side and rear of the home will be Marvin Elevate windows. Marvin Elevate windows are Wood interior/ Fiberglass exterior. The new windows will be white to match the existing windows and will have 7/8" Simulated divided light grids in patterns to match what is on the home. As this is an insert replacement job, all existing exterior trim will remain. All windows will be the same style as the windows that they are replacing.

REVIEWED

By Laura DiPasquale at 2:45 pm, Oct 29, 2025

APPROVED

Montgomery County

Historic Preservation Commission

Karen B. Smith

Front Elevation (Signature)



REVIEWED

By Laura DiPasquale at 2:46 pm, Oct 29, 2025

APPROVED

Montgomery County

Historic Preservation Commission

Karen Benoit

Left Elevation (Elevate)

W15

W16

W18

W17

W19

REVIEWED

By Laura DiPasquale at 2:46 pm, Oct 29, 2025

APPROVED

Montgomery County

Historic Preservation Commission

Karen Benoit

Right Elevation (Elevate)

W26

REVIEWED

By Laura DiPasquale at 2:46 pm, Oct 29, 2025

APPROVED

Montgomery County

Historic Preservation Commission

Karen Boudin

Rear Elevation (Signature)



REVIEWED

By Laura DiPasquale at 2:46 pm, Oct 29, 2025


APPROVED

Montgomery County


Historic Preservation Commission

Karen Benoit


Type 2

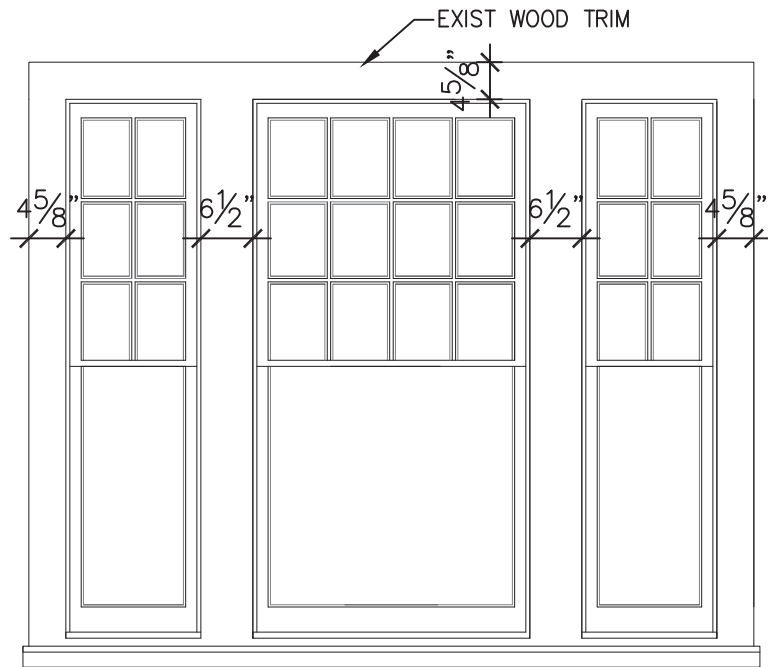

EXTERIOR-EXIST

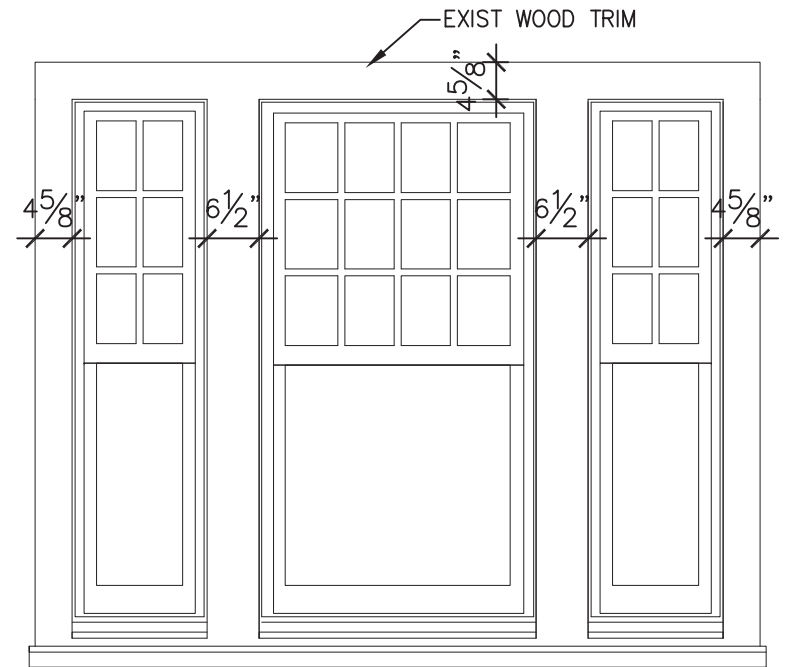

EXTERIOR-PROPOSED

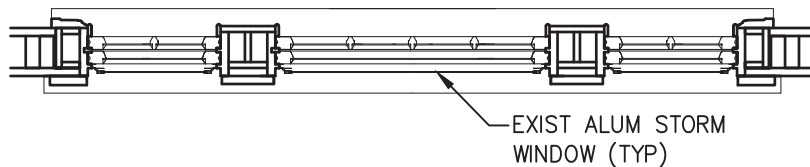

PLAN-EXIST



PLAN-PROPOSED

FIRST FLOOR FRONT/REAR

FRONT ELEV: Marvin Signature Aluminum Clad.

REVIEWED

By Laura DiPasquale at 2:46 pm, Oct 29, 2025

APPROVED

Montgomery County


Historic Preservation Commission

Karen Buelit


KJD ARCHITECTS

4904 AURORA DRIVE, LLC
KENSINGTON, MARYLAND 20895


Type 3

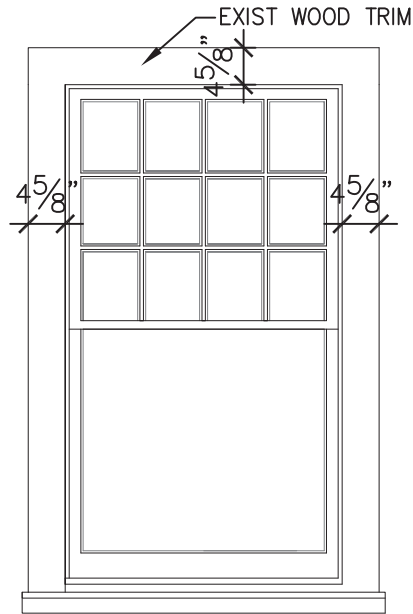


EXTERIOR-EXIST

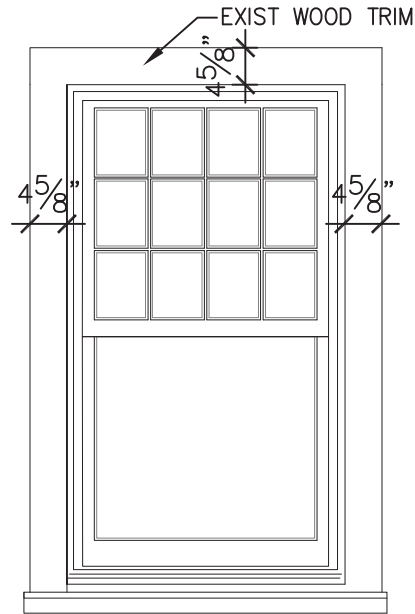

EXTERIOR-PROPOSED

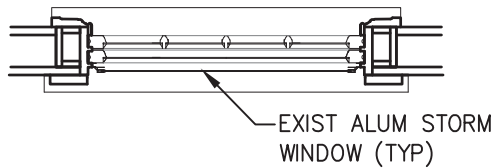

PLAN-EXIST

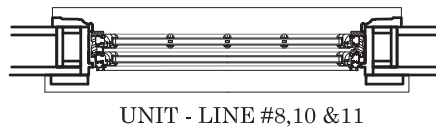

PLAN-PROPOSED

SECOND FL FRONT/REAR/SIDES

FRONT ELEV: Marvin Signature Aluminum Clad.

REVIEWED

By Laura DiPasquale at 2:46 pm, Oct 29, 2025

APPROVED

Montgomery County


Historic Preservation Commission

Karen Benoit


D ARCHITECTS

4904 AURORA DRIVE, LLC
SINGTON, MARYLAND 20895


Type 4

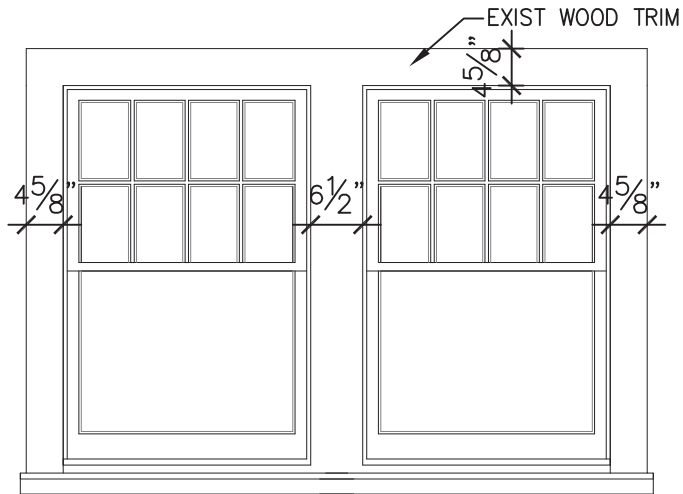


EXTERIOR-EXIST

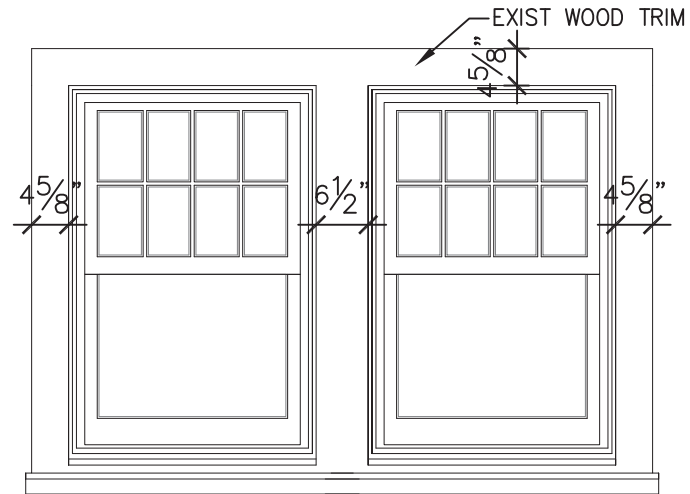

EXTERIOR-PROPOSED

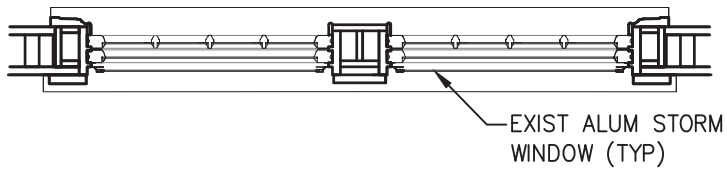

PLAN-EXIST

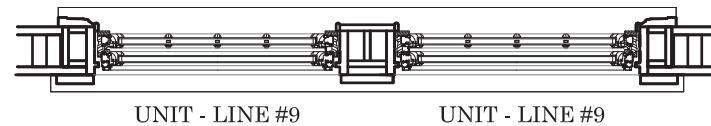

PLAN-PROPOSED

SECOND FLOOR FRONT


FRONT ELEV: Marvin Signature Aluminum Clad.




REVIEWED

By Laura DiPasquale at 2:46 pm, Oct 29, 2025


KJD ARCHITECTS
4904 AURORA DRIVE
KENSINGTON, MARYLAND 20895

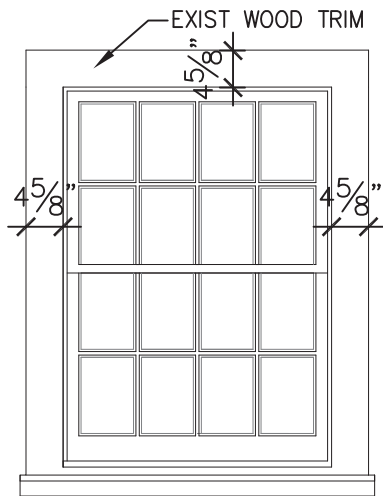


EXTERIOR-EXIST

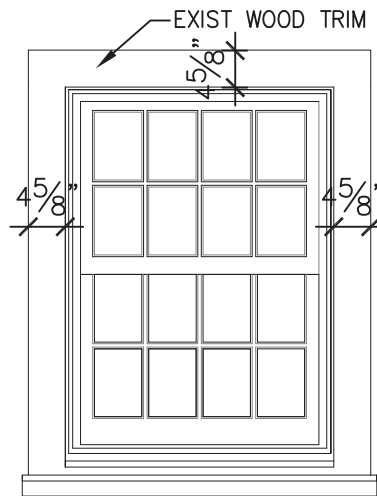

EXTERIOR-PROPOSED

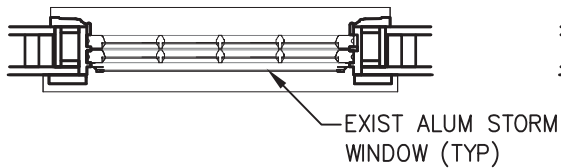


PLAN-EXIST

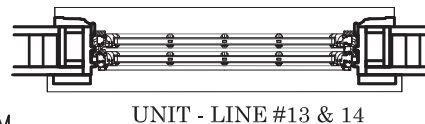

PLAN-PROPOSED

THIRD FLOOR FRONT


FRONT ELEV: Marvin Signature Aluminum Clad.

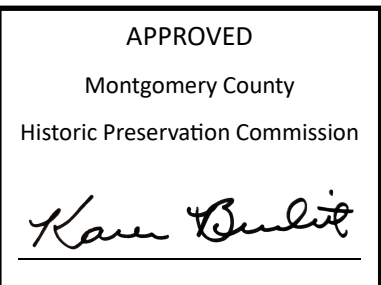

REVIEWED


By Laura DiPasquale at 2:46 pm, Oct 29, 2025

KJD ARCHITECTS
4904 AURORA DRIVE
KENSINGTON, MARYLAND 20895

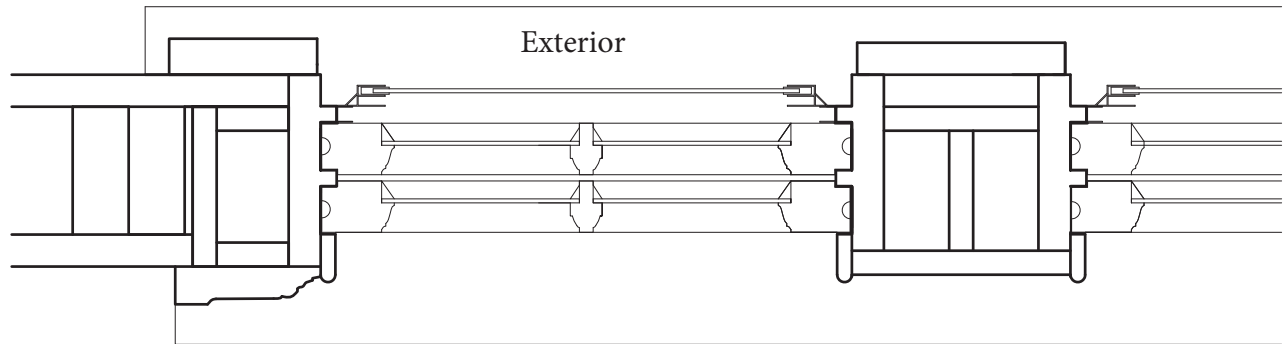

EXISTING JAMB





3"=1'-0"

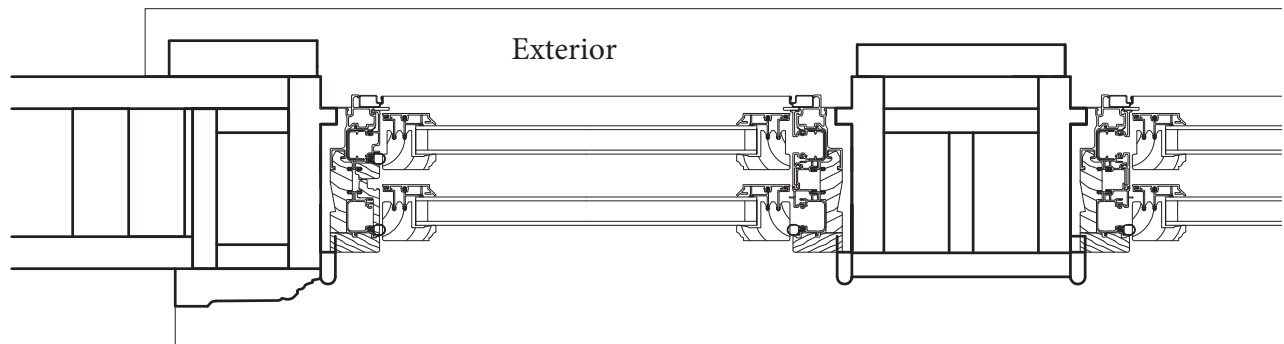

PROPOSED JAMB

3"=1'-0"

FRONT WINDOW TYPICAL

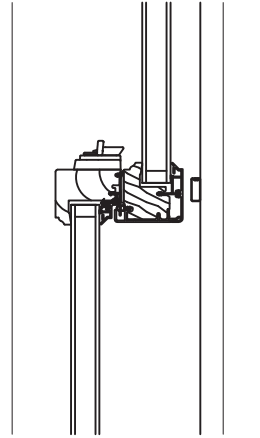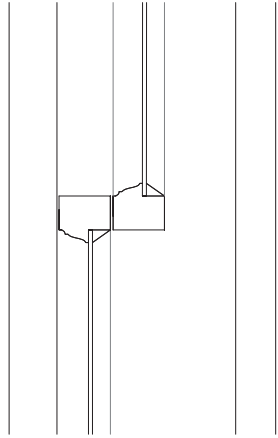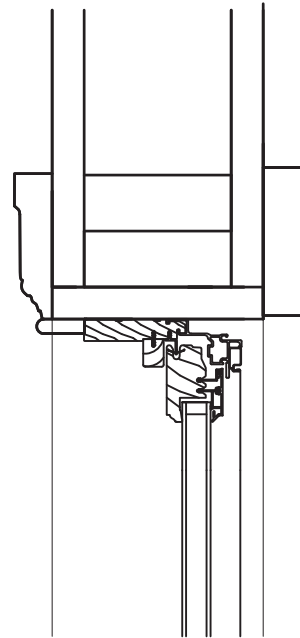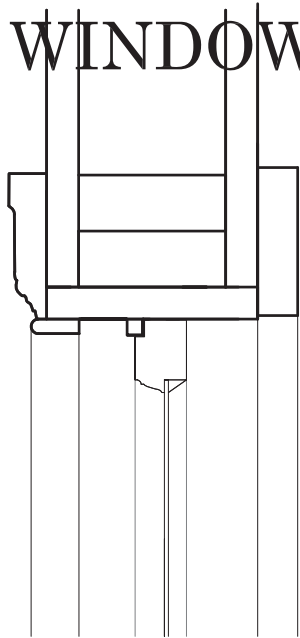

REVIEWED

By Laura DiPasquale at 2:47 pm, Oct 29, 2025

APPROVED


Montgomery County

Historic Preservation Commission

Karen Buelit

EXISTING

PROPOSED

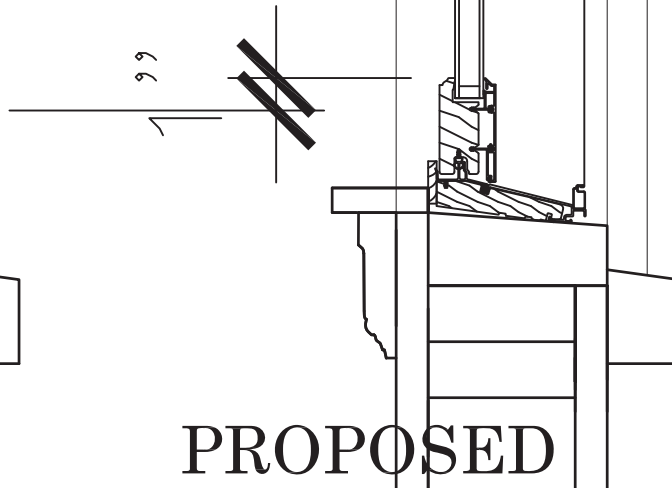

REVIEWED


By Laura DiPasquale at 2:47 pm, Oct 29, 2025

APPROVED

Montgomery County

Historic Preservation Commission

Karen Benoit

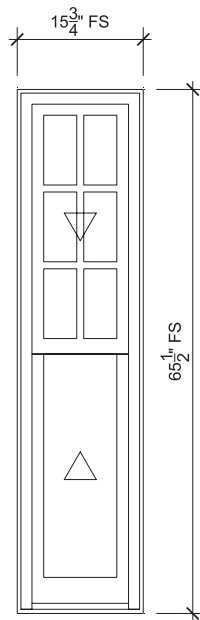

W9, W11 (FRONT)

SCALE: 1/2" = 1'-0"

-  Head
-  Jamb
-  Sill
-  Divided Lite
-  Checkrail

SPECIFICATIONS

Line #: 1

Qty: 2

Mark Unit: W9, W11 (front)

Product Line: Ultimate

Unit Description: Double Hung Insert G2

Frame Size: 15 3/4" X 65 1/2"

Exterior Finish: Stone White

Species: Pine

Interior Finish: Painted Interior Finish - White

Glass Information: IG, Low E2 w/Argon, Silver

Divider Type: 7/8" Rectangular SDL W/ Spacer - Silver, None

Hardware Type: Sash Lock, Lift Type : None, No Finger Pull, Top Sash Limiter : None,

Bottom Sash Limiter : None

Screen Type: No Screen

Hardware Color: Antique Brass

Screen Surround Color: None

Screen Mesh Type: None

Jamb Depth: 3 1/4

Subsill: None



PROJ/JOB: Allison Giles Windows / Ultimate and Elevate

DIST/DEALER: ALCO PRODUCTS COMPANY INC-CIR

DRAWN: HOWIE KREISMAN

QUOTE#: HRB4E25

PK VER: 0004.18.00

CREATED: 10/28/2025

REVISION:

SHEET

1

OF 20

REVIEWED


By Laura DiPasquale at 2:47 pm, Oct 29, 2025

APPROVED

Montgomery County

Historic Preservation Commission

Karen Benoit

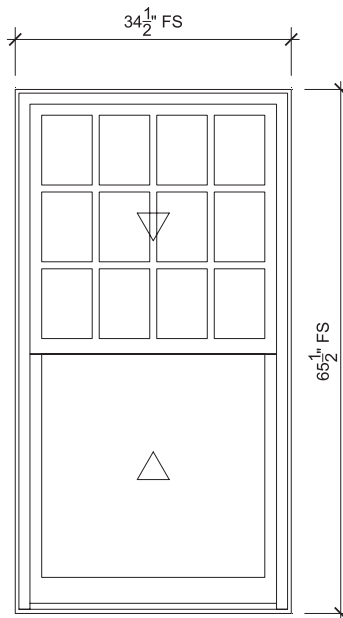

W10 (FRONT)

SCALE: 1/2" = 1'-0"

-  Head
-  Jamb
-  Sill
-  Divided Lite
-  Checkrail

SPECIFICATIONS

Line #: 2

Qty: 1

Mark Unit: W10 (Front)

Product Line: Ultimate

Unit Description: Double Hung Insert G2

Frame Size: 34 1/2" X 65 1/2"

Exterior Finish: Stone White

Species: Pine

Interior Finish: Painted Interior Finish - White

Glass Information: IG, Low E2 w/Argon, Silver

Divider Type: 7/8" Rectangular SDL W/ Spacer - Silver, None

Hardware Type: Sash Lock, Lift Type : None, No Finger Pull, Top Sash Limiter : None,

Bottom Sash Limiter : None

Screen Type: No Screen

Hardware Color: Antique Brass

Screen Surround Color: None

Screen Mesh Type: None

Jamb Depth: 3 1/4

Subsill: None



PROJ/JOB: Allison Giles Windows / Ultimate and Elevate

DIST/DEALER: ALCO PRODUCTS COMPANY INC-CIR

DRAWN: HOWIE KREISMAN

QUOTE#: HRB4E25

PK VER: 0004.18.00

CREATED: 10/28/2025

REVISION:

SHEET

2

OF 20


REVIEWED

By Laura DiPasquale at 2:47 pm, Oct 29, 2025

APPROVED

Montgomery County
Historic Preservation Commission

Karen Benoit

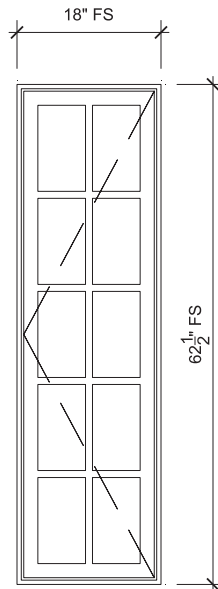

W17,W18,W19 (LEFT)

SCALE: 1/2" = 1'-0"

-  Head
-  Jamb
-  Jamb
-  Sill
-  Divided Lite

SPECIFICATIONS

Line #: 3
Qty: 3
Mark Unit: W17,W18,W19 (Left)
Product Line: Elevate
Unit Description: Casement
Frame Size: 18" X 62 1/2"
Exterior Finish: Stone White
Species: None
Interior Finish: White
Glass Information: IG, Low E2 w/Argon, Silver
Divider Type: 7/8" Rectangular SDL W/ Spacer - Silver
Hardware Type: Folding Handle, Sash Limiter : None
Screen Type: No Screen
Hardware Color: Brass
Screen Surround Color: None
Screen Mesh Type: None
Jamb Depth: 4 9/16"
Subsill: None



PROJ/JOB: Allison Giles Windows / Ultimate and Elevate
DIST/DEALER: ALCO PRODUCTS COMPANY INC-CIR
DRAWN: HOWIE KREISMAN
QUOTE#: HRB4E25

PK VER: 0004.18.00

CREATED: 10/28/2025

REVISION:

SHEET

3

OF 20


REVIEWED

By Laura DiPasquale at 2:47 pm, Oct 29, 2025

APPROVED

Montgomery County
Historic Preservation Commission

Karen Benoit

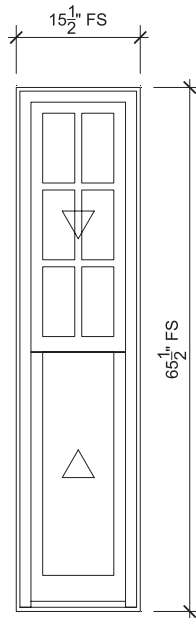

W12,W14(FRONT)

SCALE: 1/2" = 1'-0"

-  Head
-  Jamb
-  Sill
-  Divided Lite
-  Checkrail

SPECIFICATIONS

Line #: 4

Qty: 2

Mark Unit: W12,W14(Front)

Product Line: Ultimate

Unit Description: Double Hung Insert G2

Frame Size: 15 1/2" X 65 1/2"

Exterior Finish: Stone White

Species: Pine

Interior Finish: Painted Interior Finish - White

Glass Information: IG, Low E2 w/Argon, Silver

Divider Type: 7/8" Rectangular SDL W/ Spacer - Silver, None

Hardware Type: Sash Lock, Lift Type : None, No Finger Pull, Top Sash Limiter : None,

Bottom Sash Limiter : None

Screen Type: No Screen

Hardware Color: Antique Brass

Screen Surround Color: None

Screen Mesh Type: None

Jamb Depth: 3 1/4

Subsill: None



PROJ/JOB: Allison Giles Windows / Ultimate and Elevate

DIST/DEALER: ALCO PRODUCTS COMPANY INC-CIR

DRAWN: HOWIE KREISMAN

QUOTE#: HRB4E25

PK VER: 0004.18.00

CREATED: 10/28/2025

REVISION:

SHEET

4

OF 20

REVIEWED


By Laura DiPasquale at 2:47 pm, Oct 29, 2025

APPROVED

Montgomery County

Historic Preservation Commission

Karen Benoit

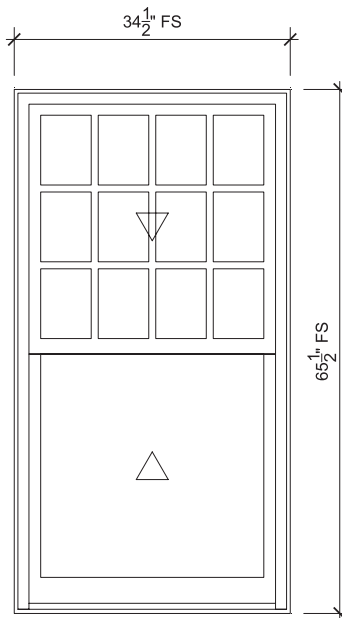

W13 (FRONT)

SCALE: 1/2" = 1'-0"



Head



Jamb



Sill



Divided Lite



Checkrail

SPECIFICATIONS

Line #: 5

Qty: 1

Mark Unit: W13 (Front)

Product Line: Ultimate

Unit Description: Double Hung Insert G2

Frame Size: 34 1/2" X 65 1/2"

Exterior Finish: Stone White

Species: Pine

Interior Finish: Painted Interior Finish - White

Glass Information: IG, Low E2 w/Argon, Silver

Divider Type: 7/8" Rectangular SDL W/ Spacer - Silver, None

Hardware Type: Sash Lock, Lift Type : None, No Finger Pull, Top Sash Limiter : None,

Bottom Sash Limiter : None

Screen Type: No Screen

Hardware Color: Antique Brass

Screen Surround Color: None

Screen Mesh Type: None

Jamb Depth: 3 1/4

Subsill: None



PROJ/JOB: Allison Giles Windows / Ultimate and Elevate

DIST/DEALER: ALCO PRODUCTS COMPANY INC-CIR

DRAWN: HOWIE KREISMAN

QUOTE#: HRB4E25

PK VER: 0004.18.00

CREATED: 10/28/2025

REVISION:

SHEET

5

OF 20


REVIEWED

By Laura DiPasquale at 2:47 pm, Oct 29, 2025

APPROVED

Montgomery County
Historic Preservation Commission

Karen Benoit

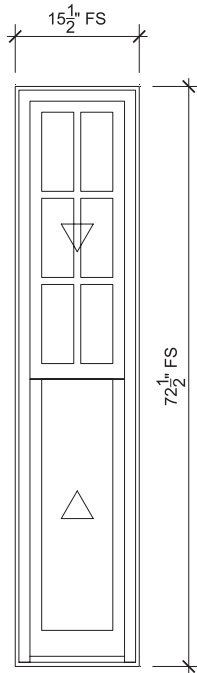

W20, W22 (REAR)

SCALE: 1/2" = 1'-0"

- Head
- Jamb
- Sill
- Divided Lite
- Checkrail

SPECIFICATIONS

Line #: 6

Qty: 2

Mark Unit: W20, W22 (Rear)

Product Line: Ultimate

Unit Description: Double Hung Insert G2

Frame Size: 15 1/2" X 72 1/2"

Exterior Finish: Stone White

Species: Pine

Interior Finish: Painted Interior Finish - White

Glass Information: IG, Low E2 w/Argon, Silver

Divider Type: 7/8" Rectangular SDL W/ Spacer - Silver, None

Hardware Type: Sash Lock, Lift Type : None, No Finger Pull, Top Sash Limiter : None,

Bottom Sash Limiter : None

Screen Type: Extruded Aluminum Half Screen

Hardware Color: Antique Brass

Screen Surround Color: Stone White

Screen Mesh Type: Bright View Mesh

Jamb Depth: 3 1/4

Subsill: None



PROJ/JOB: Allison Giles Windows / Ultimate and Elevate

DIST/DEALER: ALCO PRODUCTS COMPANY INC-CIR

DRAWN: HOWIE KREISMAN

QUOTE#: HRB4E25

PK VER: 0004.18.00


CREATED: 10/28/2025

REVISION:

SHEET

6

OF 20

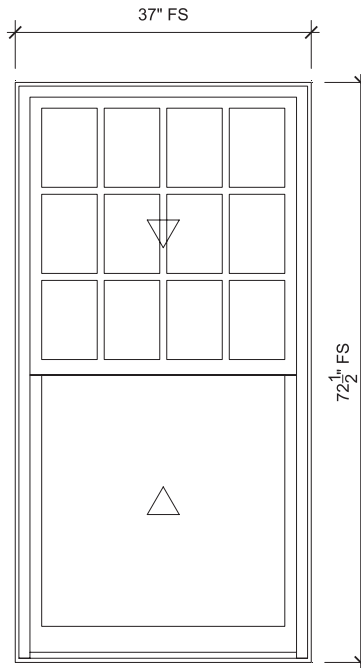

REVIEWED

By Laura DiPasquale at 2:47 pm, Oct 29, 2025

APPROVED

Montgomery County

Historic Preservation Commission

Karen Benoit

W21 (REAR)

SCALE: 1/2" = 1'-0"

-  Head
-  Jamb
-  Sill
-  Divided Lite
-  Checkrail

SPECIFICATIONS

Line #: 7

Qty: 1

Mark Unit: W21 (Rear)

Product Line: Ultimate

Unit Description: Double Hung Insert G2

Frame Size: 37" X 72 1/2"

Exterior Finish: Stone White

Species: Pine

Interior Finish: Painted Interior Finish - White

Glass Information: IG, Low E2 w/Argon, Silver

Divider Type: 7/8" Rectangular SDL W/ Spacer - Silver, None

Hardware Type: Sash Lock, Lift Type : None, No Finger Pull, Top Sash Limiter : None,

Bottom Sash Limiter : None

Screen Type: Extruded Aluminum Half Screen

Hardware Color: Antique Brass

Screen Surround Color: Stone White

Screen Mesh Type: Bright View Mesh

Jamb Depth: 3 1/4

Subsill: None



PROJ/JOB: Allison Giles Windows / Ultimate and Elevate

DIST/DEALER: ALCO PRODUCTS COMPANY INC-CIR

DRAWN: HOWIE KREISMAN

QUOTE#: HRB4E25

PK VER: 0004.18.00

CREATED: 10/28/2025

REVISION:


SHEET

7

OF 20

REVIEWED

By Laura DiPasquale at 2:47 pm, Oct 29, 2025

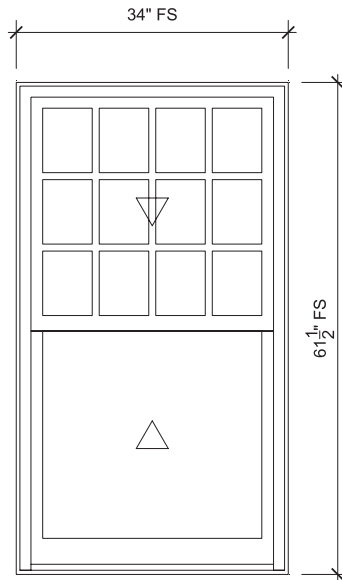

APPROVED

Montgomery County

Historic Preservation Commission

Karen Benoit

W4,W7,W8 (FRONT)

SCALE: 1/2" = 1'-0"



Head



Jamb



Sill



Divided Lite



Checkrail

SPECIFICATIONS

Line #: 8

Qty: 3

Mark Unit: W4,W7,W8 (Front)

Product Line: Ultimate

Unit Description: Double Hung Insert G2

Frame Size: 34" X 61 1/2"

Exterior Finish: Stone White

Species: Pine

Interior Finish: Painted Interior Finish - White

Glass Information: IG, Low E2 w/Argon, Black

Divider Type: 7/8" Rectangular SDL W/ Spacer - Black, None

Hardware Type: Sash Lock, Lift Type : None, No Finger Pull, Top Sash Limiter : None,

Bottom Sash Limiter : None

Screen Type: Extruded Aluminum Screen

Hardware Color: Brass

Screen Surround Color: Stone White

Screen Mesh Type: Bright View Mesh

Jamb Depth: 3 1/4

Subsill: None



PROJ/JOB: Allison Giles Windows / Ultimate and Elevate

DIST/DEALER: ALCO PRODUCTS COMPANY INC-CIR

DRAWN: HOWIE KREISMAN

QUOTE#: HRB4E25

PK VER: 0004.18.00


CREATED: 10/28/2025

REVISION:

SHEET

8

OF 20

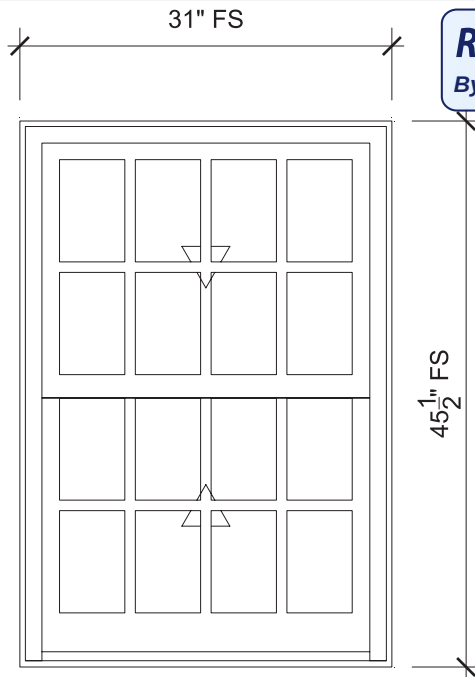

REVIEWED

By Laura DiPasquale at 2:47 pm, Oct 29, 2025

APPROVED

Montgomery County

Historic Preservation Commission

Karen Benoit

W5,W6 (FRONT)

SCALE: 3/4" = 1'-0"

$\frac{4}{18}$ Head

$\frac{1}{19}$ Jamb

$\frac{2}{19}$ Sill

$\frac{4}{15}$ Divided Lite

$\frac{3}{19}$ Checkrail

SPECIFICATIONS

Line #: 9

Qty: 2

Mark Unit: W5,W6 (Front)

Product Line: Ultimate

Unit Description: Double Hung Insert G2

Frame Size: 31" X 45 1/2"

Exterior Finish: Stone White

Species: Pine

Interior Finish: Painted Interior Finish - White

Glass Information: IG, Low E2 w/Argon, Black

Divider Type: 7/8" Rectangular SDL W/ Spacer - Black

Hardware Type: Sash Lock, Lift Type : None, No Finger Pull, Top Sash Limiter : None,

Bottom Sash Limiter : None

Screen Type: Aluminum Screen

Hardware Color: Brass

Screen Surround Color: Stone White

Screen Mesh Type: Bright View Mesh

Jamb Depth: 3 1/4

Subsill: None



PROJ/JOB: Allison Giles Windows / Ultimate and Elevate

DIST/DEALER: ALCO PRODUCTS COMPANY INC-CIR

DRAWN: HOWIE KREISMAN

QUOTE#: HRB4E25

PK VER: 0004.18.00

CREATED: 10/28/2025

REVISION:


SHEET

9

OF 20

REVIEWED

By Laura DiPasquale at 2:47 pm, Oct 29, 2025

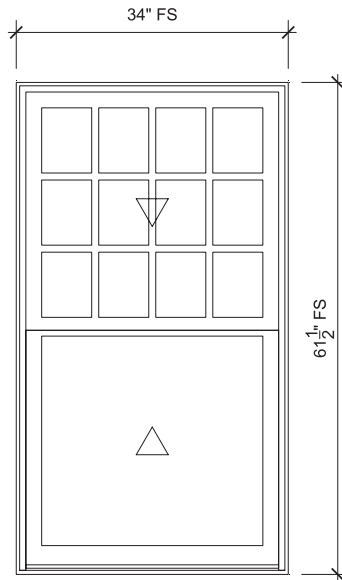

APPROVED

Montgomery County
Historic Preservation Commission

Karen Benoit

W15,16 (LEFT)

SCALE: 1/2" = 1'-0"



Head



Jamb



Sill



Divided Lite



Check Rail

SPECIFICATIONS

Line #: 10

Qty: 2

Mark Unit: W15,16 (Left)

Product Line: Elevate

Unit Description: Double Hung Insert

Frame Size: 34" X 61 1/2"

Exterior Finish: Stone White

Species: None

Interior Finish: White

Glass Information: IG, Tempered Low E2 w/Argon, Silver

Divider Type: 7/8" Rectangular SDL W/ Spacer - Silver, None

Hardware Type: Sash Lock

Screen Type: No Screen

Hardware Color: Brass

Screen Surround Color: None

Screen Mesh Type: None

Jamb Depth: 3 1/4

Subsill: None



PROJ/JOB: Allison Giles Windows / Ultimate and Elevate

DIST/DEALER: ALCO PRODUCTS COMPANY INC-CIR

DRAWN: HOWIE KREISMAN

QUOTE#: HRB4E25

PK VER: 0004.18.00


CREATED: 10/28/2025

REVISION:

SHEET

10

OF 20

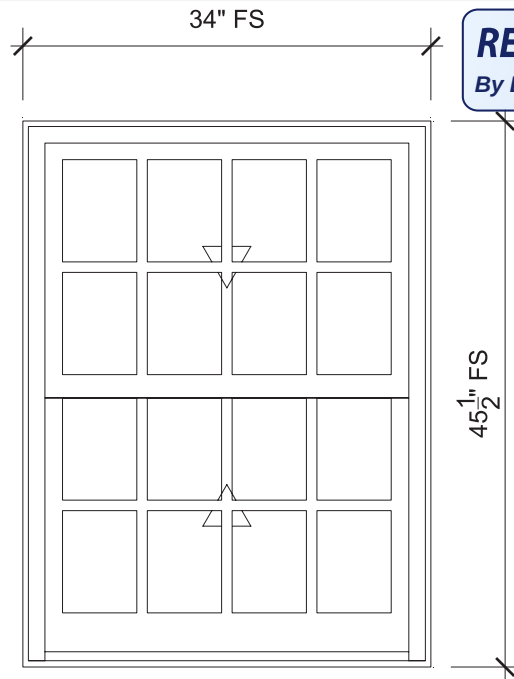

REVIEWED

By Laura DiPasquale at 2:47 pm, Oct 29, 2025

APPROVED

Montgomery County

Historic Preservation Commission

Karen Benoit

W1,W2,W3 (FRONT)

SCALE: 3/4" = 1'-0"

-  Head
-  Jamb
-  Sill
-  Divided Lite
-  Checkrail

SPECIFICATIONS

Line #: 14

Qty: 3

Mark Unit: W1,W2,W3 (Front)

Product Line: Ultimate

Unit Description: Double Hung Insert G2

Frame Size: 34" X 45 1/2"

Exterior Finish: Stone White

Species: Pine

Interior Finish: Painted Interior Finish - White

Glass Information: IG, Low E2 w/Argon, Black

Divider Type: 7/8" Rectangular SDL W/ Spacer - Black

Hardware Type: Sash Lock, Lift Type : None, No Finger Pull, Top Sash Limiter : None,

Bottom Sash Limiter : None

Screen Type: Aluminum Screen

Hardware Color: Brass

Screen Surround Color: Stone White

Screen Mesh Type: Bright View Mesh

Jamb Depth: 3 1/4

Subsill: None



PROJ/JOB: Allison Giles Windows / Ultimate and Elevate

DIST/DEALER: ALCO PRODUCTS COMPANY INC-CIR

DRAWN: HOWIE KREISMAN

QUOTE#: HRB4E25

PK VER: 0004.18.00

CREATED: 10/28/2025

REVISION:

SHEET

11

OF 20

REVIEWED


By Laura DiPasquale at 2:47 pm, Oct 29, 2025

APPROVED

Montgomery County

Historic Preservation Commission

Karen Benoit

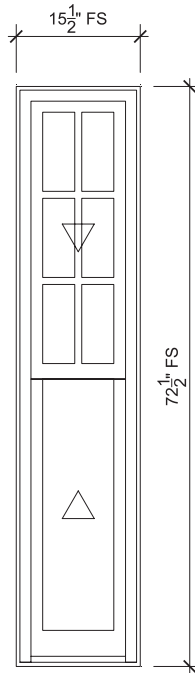

W23,W25 (REAR)

SCALE: 1/2" = 1'-0"

-  Head
-  Jamb
-  Sill
-  Divided Lite
-  Checkrail

SPECIFICATIONS

Line #: 15

Qty: 2

Mark Unit: W23,W25 (rear)

Product Line: Ultimate

Unit Description: Double Hung Insert G2

Frame Size: 15 1/2" X 72 1/2"

Exterior Finish: Stone White

Species: Pine

Interior Finish: Painted Interior Finish - White

Glass Information: IG, Low E2 w/Argon, Silver

Divider Type: 7/8" Rectangular SDL W/ Spacer - Silver, None

Hardware Type: Sash Lock, Lift Type : None, No Finger Pull, Top Sash Limiter : None,

Bottom Sash Limiter : None

Screen Type: Extruded Aluminum Half Screen

Hardware Color: Antique Brass

Screen Surround Color: Stone White

Screen Mesh Type: Bright View Mesh

Jamb Depth: 3 1/4

Subsill: None



PROJ/JOB: Allison Giles Windows / Ultimate and Elevate

DIST/DEALER: ALCO PRODUCTS COMPANY INC-CIR

DRAWN: HOWIE KREISMAN

QUOTE#: HRB4E25

PK VER: 0004.18.00


CREATED: 10/28/2025

REVISION:

SHEET

12

OF 20

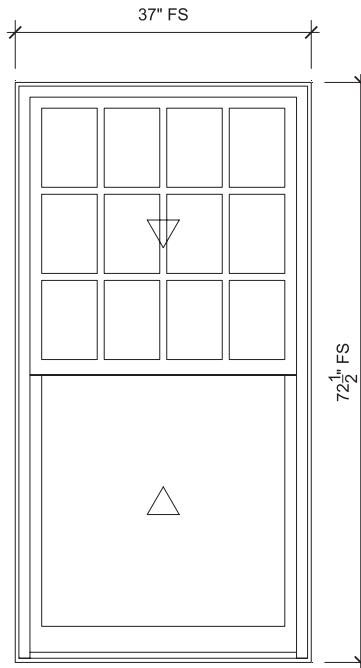

REVIEWED

By Laura DiPasquale at 2:47 pm, Oct 29, 2025

APPROVED

Montgomery County

Historic Preservation Commission

Karen Benoit

W24 (REAR)

SCALE: 1/2" = 1'-0"



Head



Jamb



Sill



Divided Lite



Checkrail

SPECIFICATIONS

Line #: 16

Qty: 1

Mark Unit: W24 (Rear)

Product Line: Ultimate

Unit Description: Double Hung Insert G2

Frame Size: 37" X 72 1/2"

Exterior Finish: Stone White

Species: Pine

Interior Finish: Painted Interior Finish - White

Glass Information: IG, Low E2 w/Argon, Silver

Divider Type: 7/8" Rectangular SDL W/ Spacer - Silver, None

Hardware Type: Sash Lock, Lift Type : None, No Finger Pull, Top Sash Limiter : None,

Bottom Sash Limiter : None

Screen Type: Extruded Aluminum Half Screen

Hardware Color: Antique Brass

Screen Surround Color: Stone White

Screen Mesh Type: Bright View Mesh

Jamb Depth: 3 1/4

Subsill: None



PROJ/JOB: Allison Giles Windows / Ultimate and Elevate

DIST/DEALER: ALCO PRODUCTS COMPANY INC-CIR

DRAWN: HOWIE KREISMAN

QUOTE#: HRB4E25

PK VER: 0004.18.00

CREATED: 10/28/2025

REVISION:


SHEET

13

OF 20

REVIEWED

By Laura DiPasquale at 2:47 pm, Oct 29, 2025

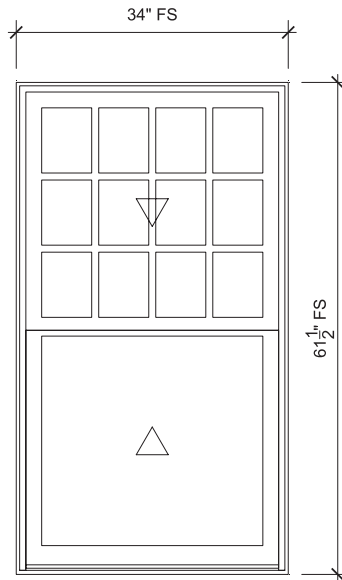

APPROVED

Montgomery County
Historic Preservation Commission

Karen Benoit

W26 (RIGHT)

SCALE: 1/2" = 1'-0"



Head



Jamb



Sill



Divided Lite



Check Rail

SPECIFICATIONS

Line #: 17

Qty: 1

Mark Unit: W26 (Right)

Product Line: Elevate

Unit Description: Double Hung Insert

Frame Size: 34" X 61 1/2"

Exterior Finish: Stone White

Species: None

Interior Finish: White

Glass Information: IG, Low E2 w/Argon, Silver

Divider Type: 7/8" Rectangular SDL W/ Spacer - Silver, None

Hardware Type: Sash Lock

Screen Type: No Screen

Hardware Color: Brass

Screen Surround Color: None

Screen Mesh Type: None

Jamb Depth: 3 1/4

Subsill: None



PROJ/JOB: Allison Giles Windows / Ultimate and Elevate

DIST/DEALER: ALCO PRODUCTS COMPANY INC-CIR

DRAWN: HOWIE KREISMAN

QUOTE#: HRB4E25

PK VER: 0004.18.00

CREATED: 10/28/2025

REVISION:

SHEET

14


OF 20

APPROVED
Montgomery County
Historic Preservation Commission

Karen Buelit

REVIEWED


By Laura DiPasquale at 2:47 pm, Oct 29, 2025

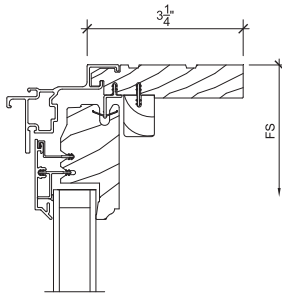

1
15

Head


SCALE: 3" = 1'-0"

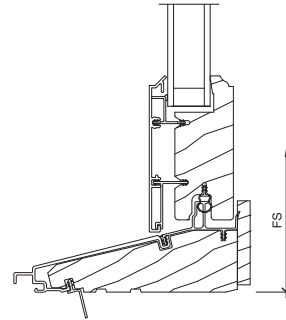

3
15

Sill


SCALE: 3" = 1'-0"

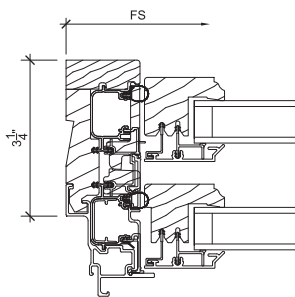

2
15

Jamb

SCALE: 3" = 1'-0"

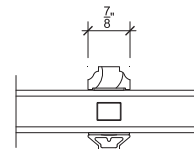

4
15

Divided Lite

SCALE: 3" = 1'-0"



PROJ/JOB: Allison Giles Windows / Ultimate and Elevate
DIST/DEALER: ALCO PRODUCTS COMPANY INC-CIR
DRAWN: HOWIE KREISMAN
QUOTE#: HRB4E25 PK VER: 0004.18.00

CREATED: 10/28/2025 REVISION:

SHEET

15


OF 20

APPROVED
Montgomery County
Historic Preservation Commission

Karen Buelit

REVIEWED


By Laura DiPasquale at 2:47 pm, Oct 29, 2025

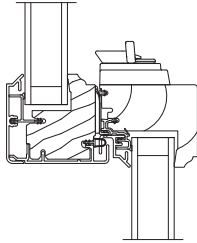

1
16

Checkrail


SCALE: 3" = 1'-0"

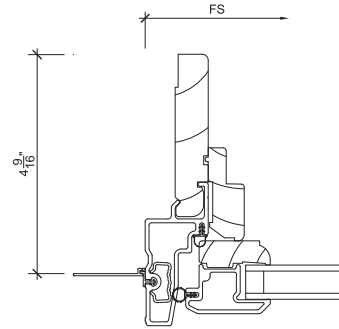

3
16

Jamb


SCALE: 3" = 1'-0"

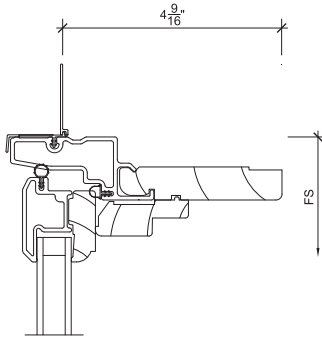

2
16

Head

SCALE: 3" = 1'-0"

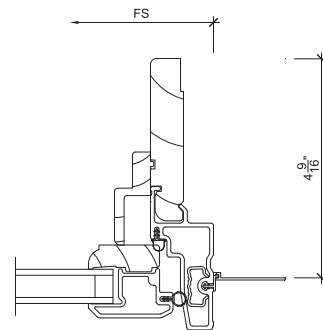

4
16

Jamb

SCALE: 3" = 1'-0"



PROJ/JOB: Allison Giles Windows / Ultimate and Elevate
DIST/DEALER: ALCO PRODUCTS COMPANY INC-CIR
DRAWN: HOWIE KREISMAN
QUOTE#: HRB4E25 PK VER: 0004.18.00

CREATED: 10/28/2025 REVISION:

SHEET

16


OF 20

APPROVED
Montgomery County
Historic Preservation Commission

Karen Buelit

REVIEWED


By Laura DiPasquale at 2:47 pm, Oct 29, 2025

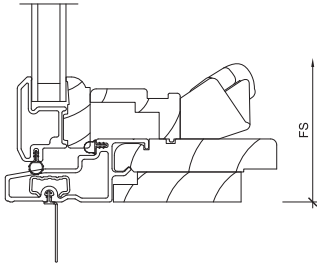

1
17

Sill


SCALE: 3" = 1'-0"

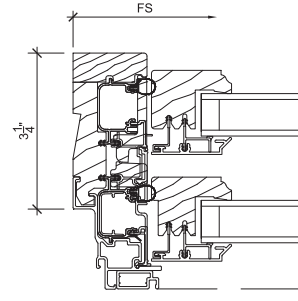

3
17

Jamb


SCALE: 3" = 1'-0"

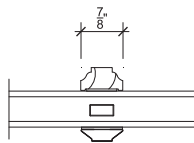

2
17

Divided Lite

SCALE: 3" = 1'-0"

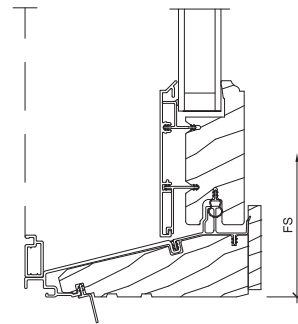

4
17

Sill

SCALE: 3" = 1'-0"



PROJ/JOB: Allison Giles Windows / Ultimate and Elevate
DIST/DEALER: ALCO PRODUCTS COMPANY INC-CIR
DRAWN: HOWIE KREISMAN
QUOTE#: HRB4E25 PK VER: 0004.18.00

CREATED: 10/28/2025 REVISION:

SHEET

17


OF 20

APPROVED
Montgomery County
Historic Preservation Commission

Karen Benoit

REVIEWED


By Laura DiPasquale at 2:47 pm, Oct 29, 2025

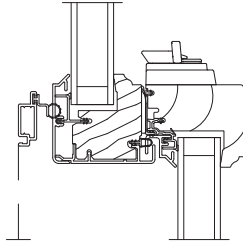

1
18

Checkrail


SCALE: 3" = 1'-0"

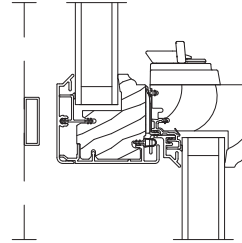

3
18

Checkrail


SCALE: 3" = 1'-0"

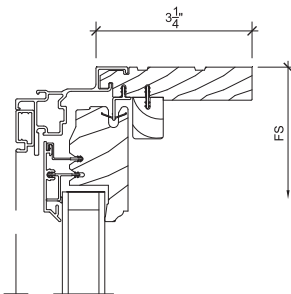

2
18

Head

SCALE: 3" = 1'-0"

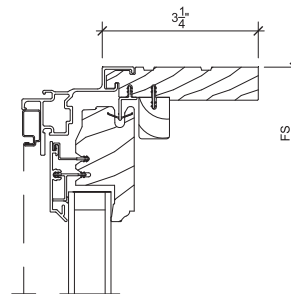

4
18

Head

SCALE: 3" = 1'-0"



PROJ/JOB: Allison Giles Windows / Ultimate and Elevate
DIST/DEALER: ALCO PRODUCTS COMPANY INC-CIR
DRAWN: HOWIE KREISMAN
QUOTE#: HRB4E25 PK VER: 0004.18.00

CREATED: 10/28/2025 REVISION:

SHEET

18


OF 20

APPROVED
Montgomery County
Historic Preservation Commission

Karen Benoit

REVIEWED


By Laura DiPasquale at 2:47 pm, Oct 29, 2025

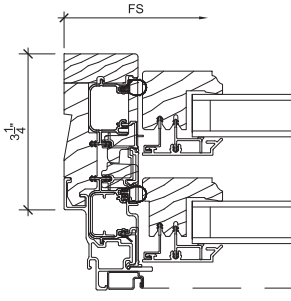

1
19

Jamb


SCALE: 3" = 1'-0"

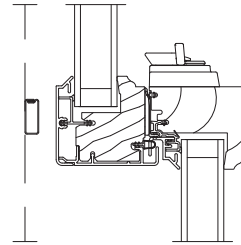

3
19

Checkrail


SCALE: 3" = 1'-0"

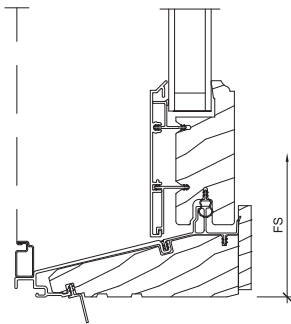

2
19

Sill

SCALE: 3" = 1'-0"

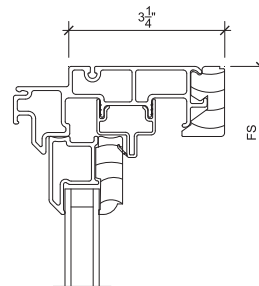

4
19

Head

SCALE: 3" = 1'-0"



PROJ/JOB: Allison Giles Windows / Ultimate and Elevate
DIST/DEALER: ALCO PRODUCTS COMPANY INC-CIR
DRAWN: HOWIE KREISMAN
QUOTE#: HRB4E25 PK VER: 0004.18.00

CREATED: 10/28/2025 REVISION:

SHEET

19


OF 20

APPROVED
Montgomery County
Historic Preservation Commission

Karen Benoit

REVIEWED


By Laura DiPasquale at 2:47 pm, Oct 29, 2025

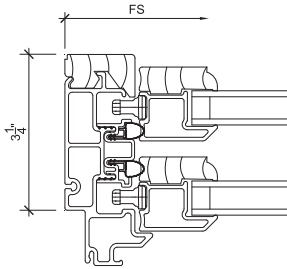

1
20

Jamb


SCALE: 3" = 1'-0"

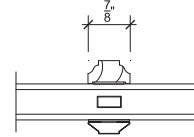

3
20

Divided Lite


SCALE: 3" = 1'-0"

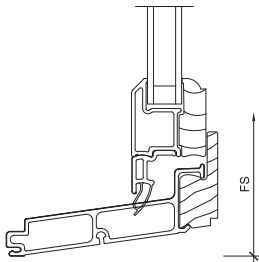

2
20

Sill

SCALE: 3" = 1'-0"

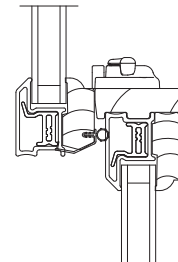

4
20

Check Rail

SCALE: 3" = 1'-0"



PROJ/JOB: Allison Giles Windows / Ultimate and Elevate
DIST/DEALER: ALCO PRODUCTS COMPANY INC-CIR
DRAWN: HOWIE KREISMAN
QUOTE#: HRB4E25 PK VER: 0004.18.00

CREATED: 10/28/2025 REVISION:

SHEET

20

OF 20