
7475 Butfalo Clok. HAWP 37/3-08E Talsoma Park

đ

6

,

•

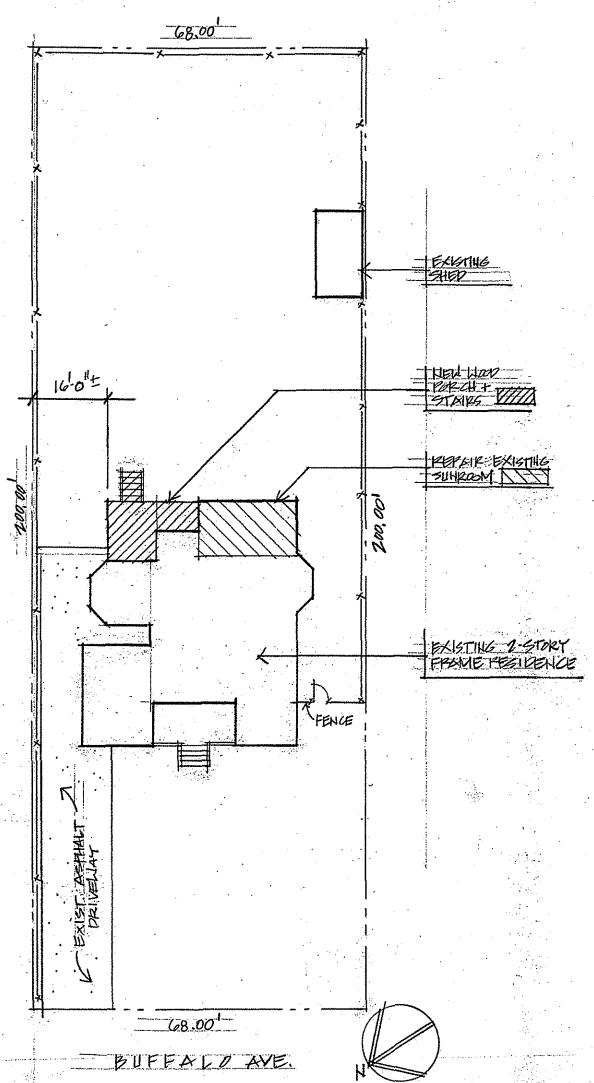

# Site Plan 1" = 20'-0"

Plat Book: 8 Lot: Part of Lot 6 Block: 75

Plat No.: 32

Subdivision: Takoma Park Loan and Trust Co's Subdivision of Takoma Park Address: 7425 Buffalo Ave., Takoma Park, MD 20912

Year lot recorded: 1918

## PROJECT DESCRIPTION:

Repair existing sunroom walls and foundation; replace existing sliding windows and door with new double hung windows and new entry door. Replace existing sliding door at 2<sup>nd</sup> Floor with 2 new double-hung windows. Construct new porch and stairs at rear of residence.

## RESIDENTIAL CODE NOTES:

All construction shall be in conformance with the International Residential Code (IRC), 2003 Edition.


## AREA CALCULATIONS

## **EXISTING:**

Lot Area: 13,600 s.f.
Lot Coverage/Building Area: 2189 s.f.
% of Lot Coverage: 16%
Height of Structure(at front grade): 32'-0" +/-

## PROPOSED:

Footprint Expansion: 120 s.f.
Total Lot Coverage/Building Area: 2309 s.f.
% Lot Coverage: 16.9%
Height of Structure(at front grade): no change

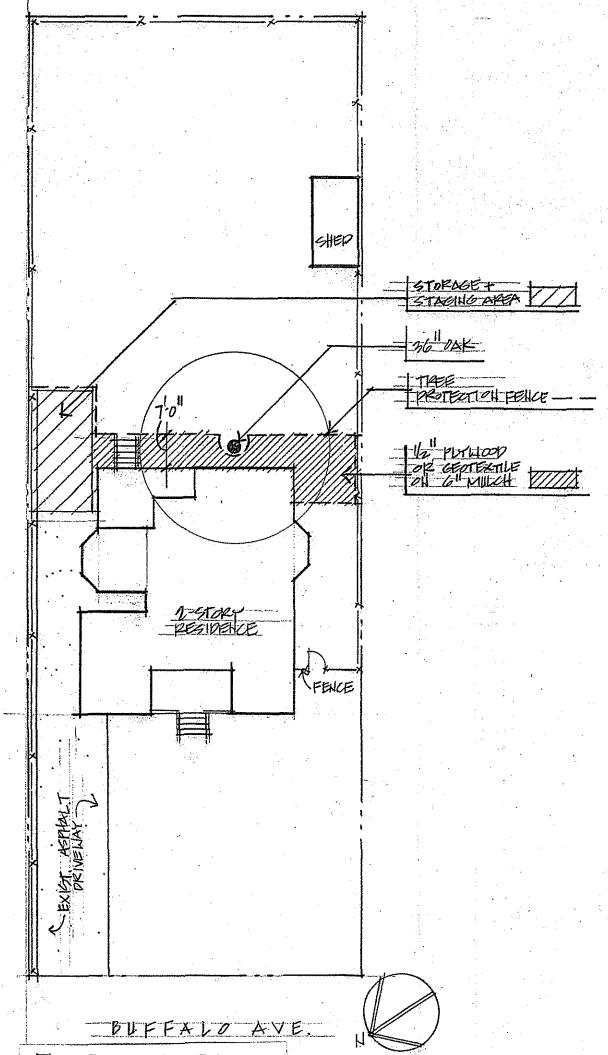

Tree Protection Plan
1" = 20'-0"

# Drainage Plan

# AREA CALCULATIONS

# EXISTING:

Lot Area: 13,600 s.f.

Lot Coverage/Building Area: 2189 s.f.

% of Lot Coverage: 16%

Height of Structure(at front grade): 32'-0"+/
Area of impervious surfaces: 3989 s.f.

# PROPOSED:

Footprint Expansion: 120 s.f.
Total Lot Coverage/Building Area: 2309 s.f.
% Lot Coverage: 16.9%
Height of Structure(at front grade): no change
Area of new impervious surfaces: 120 s.f.

Note: Since the increase in lot coverage of impervious surfaces is 120 s.f. (the rear porch extension) and is less than 400 s.f., there is no requirement for extra runoff control.

# Proposed Addition & Renovation to:

# Pilzer Residence

7425 Buffalo Ave.
Takoma Park, MD 20912

# Sheet No. Sheet Title

Cover Site Plan / Tree Protection Plan / Project Description / Project Information

# **DEMOLITION**

**D-1** Demolition Plan / First & Second Floor (1/4"=1'-0")
Window & Door Schedule
Finish Schedule

# **ARCHITECTURAL**

A-1 Foundation Plan (1/4"=1'-0")
 First & Second Floor Plan (1/4"=1'-0")

 A-2 Rear Elevation (1/4"=1'-0")
 Side Elevations (1/4"=1'-0")
 Building Section (1/4"=1'-0")

**A-3** Wall Sections (1"=1'-0")

### **STRUCTURAL**

S-1 First Floor & Second Floor Framing Plan (1/4"=1'-0")

essional Certification:
tify that these documents were prepared or
oved by me, and that I am a duly licensed
tect under the laws of the State of Maryland,
nse Numbers 8221-R. Expiration Dates 7/72,

Heritage Building & Renovation, Inc. 7334 Carroll Ave. Fakoma Park, MD 20912

Vitullo Architecture Studio, PC 7016 Woodland Ave.
Takoma Park, MD 20912


**Pilzer Residence** 7425 Buffalo Ave. Fakoma Park, MD 20912

COVER

APPROVED

Monigomery County

Historic Preservation Commission

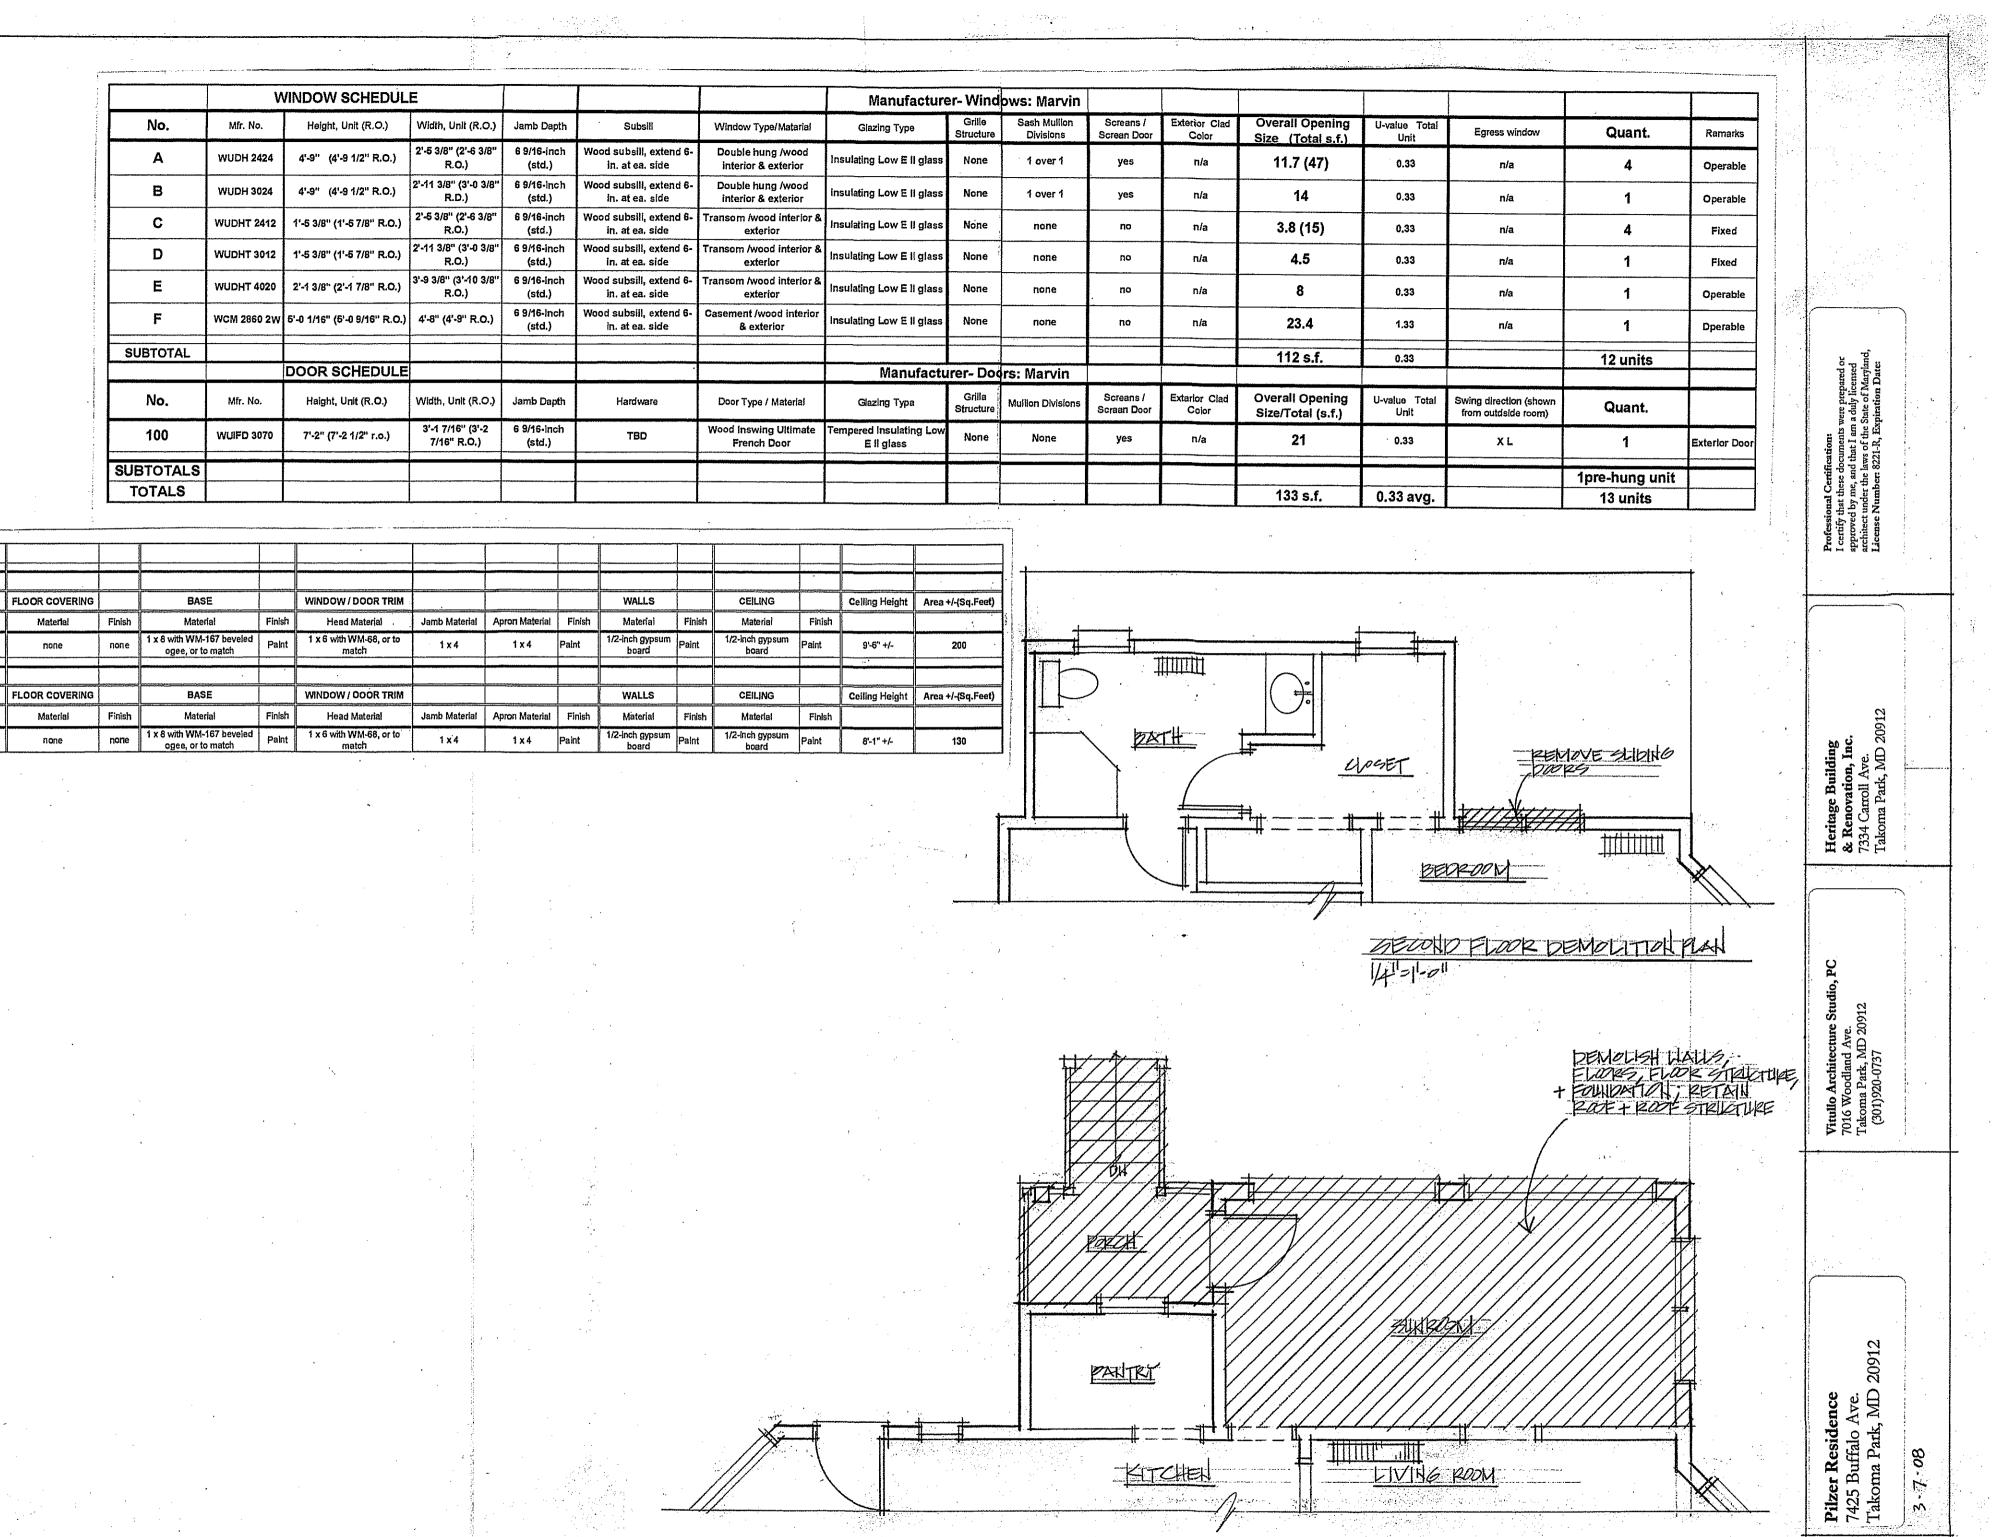

FIRST FLOOR DEMOLITION PLAN

EXIST. TO REMAIN

177 TO BE DEMOLISHED

141=1-011

D-1

FINISH SCHEDULE

FIRST FLOOR

FLOORS

SECOND FLOOR

FLOORS

Existing

New 3/4" T & G Oil-based Polyurethane


Existing

ROOM

Sunroom


ROOM


Bedroom

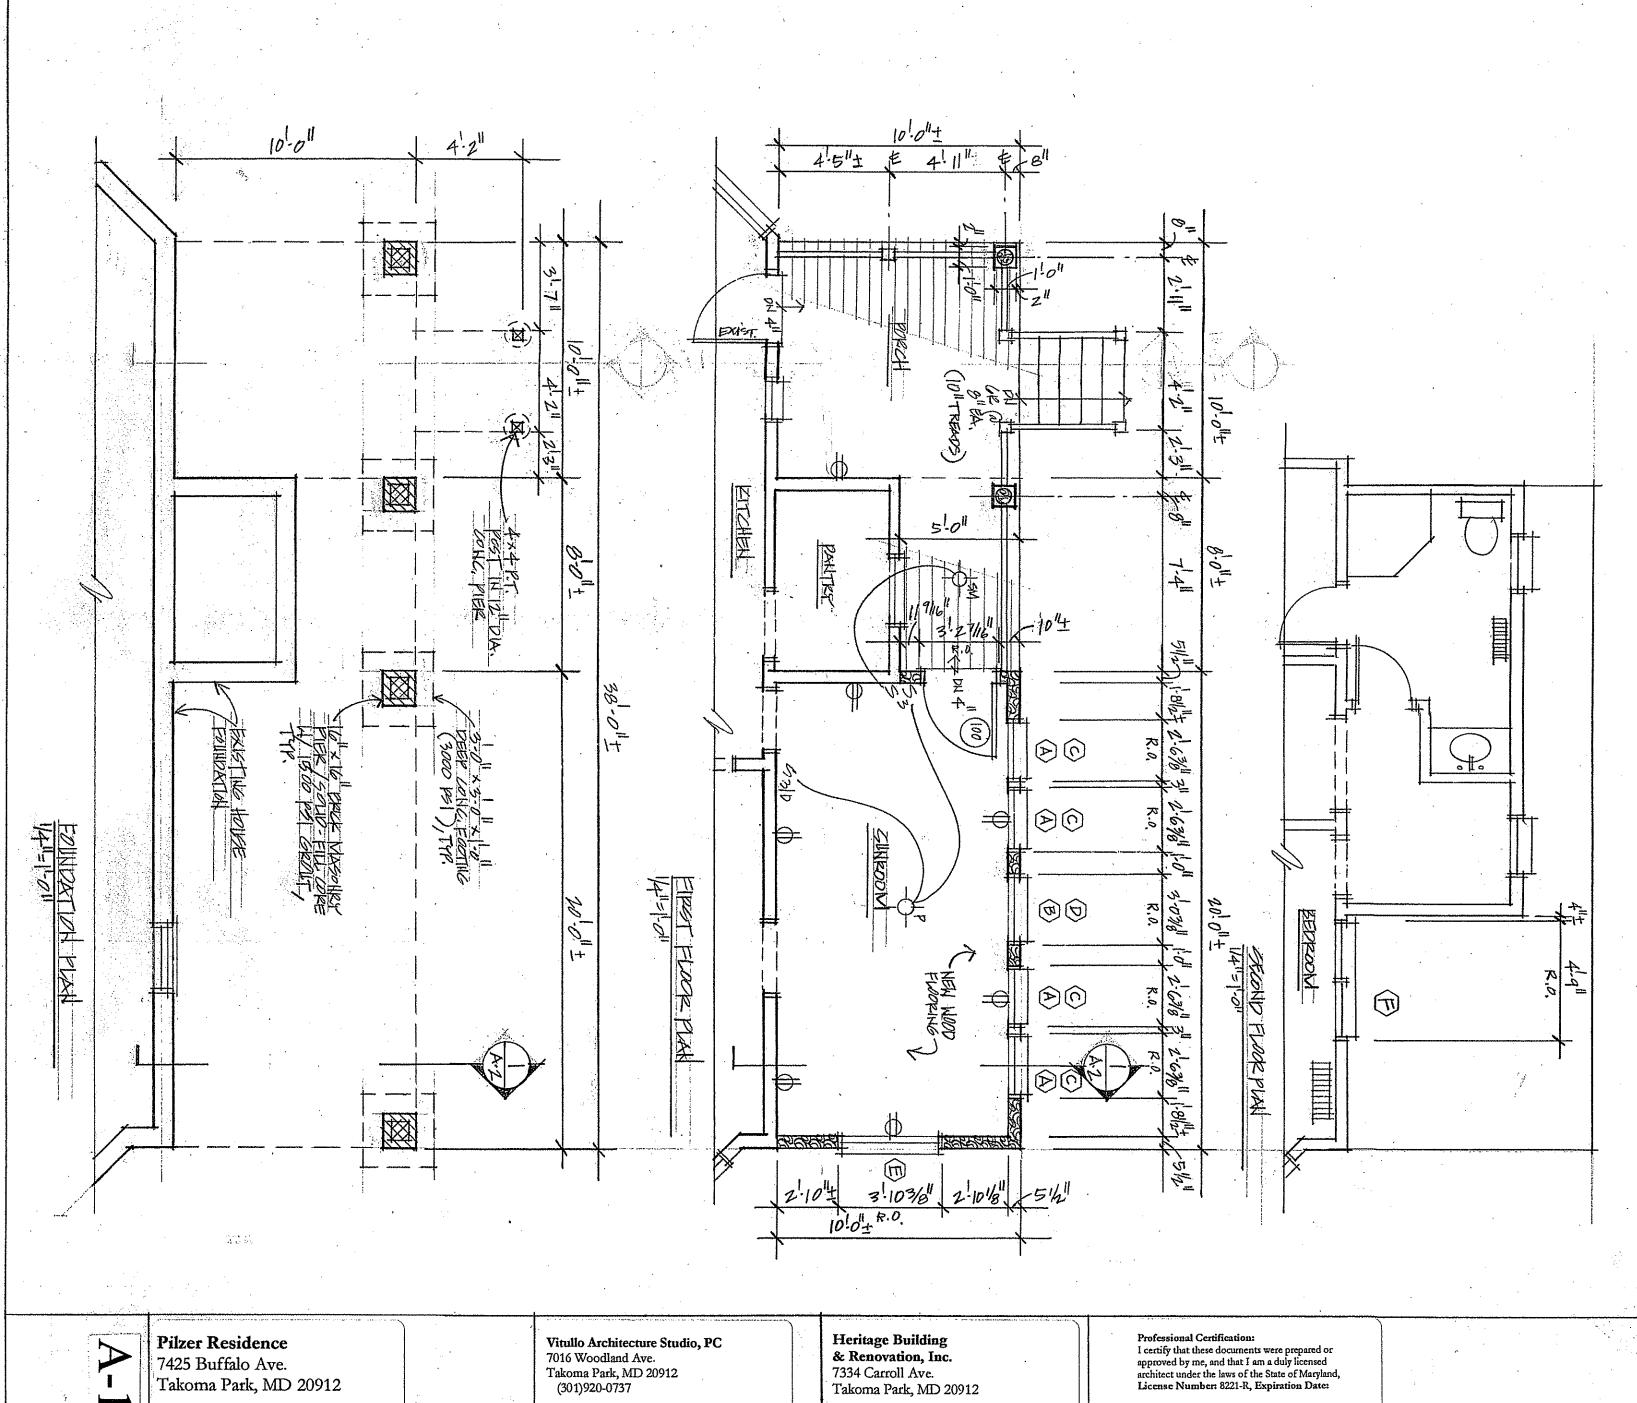


7425 Buffalo Ave. Takoma Park, MD 20912

3.7.08

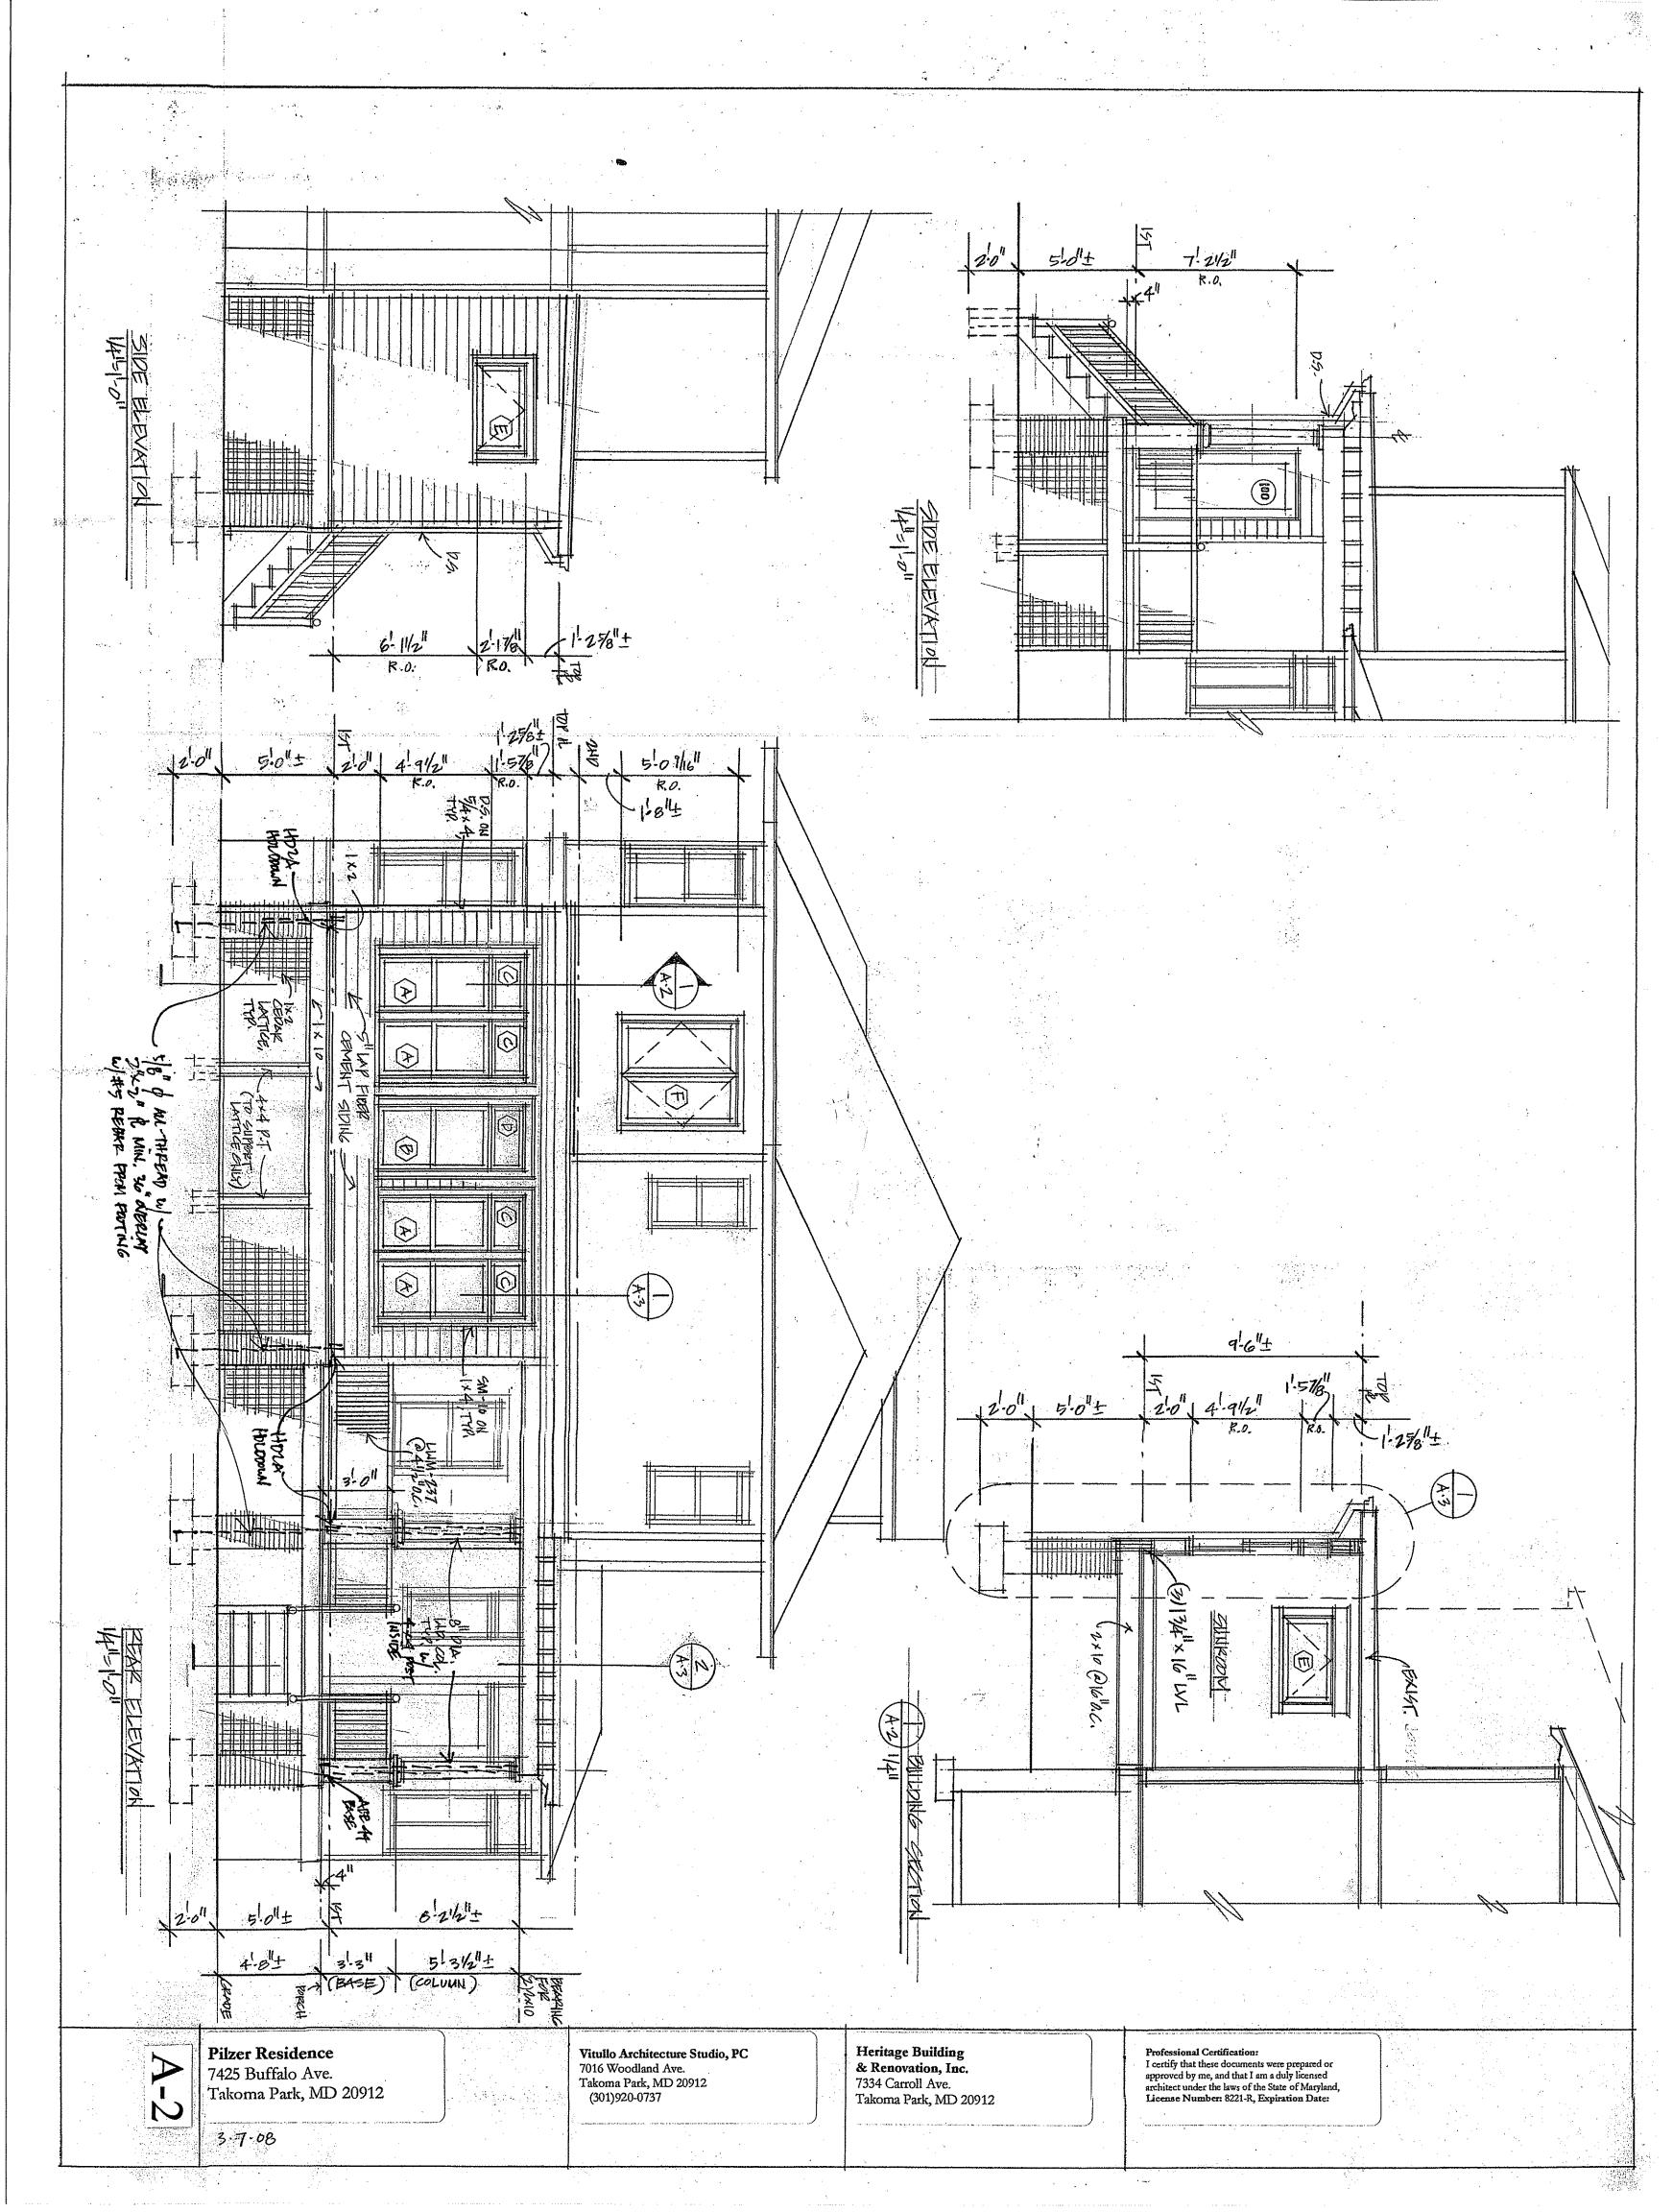

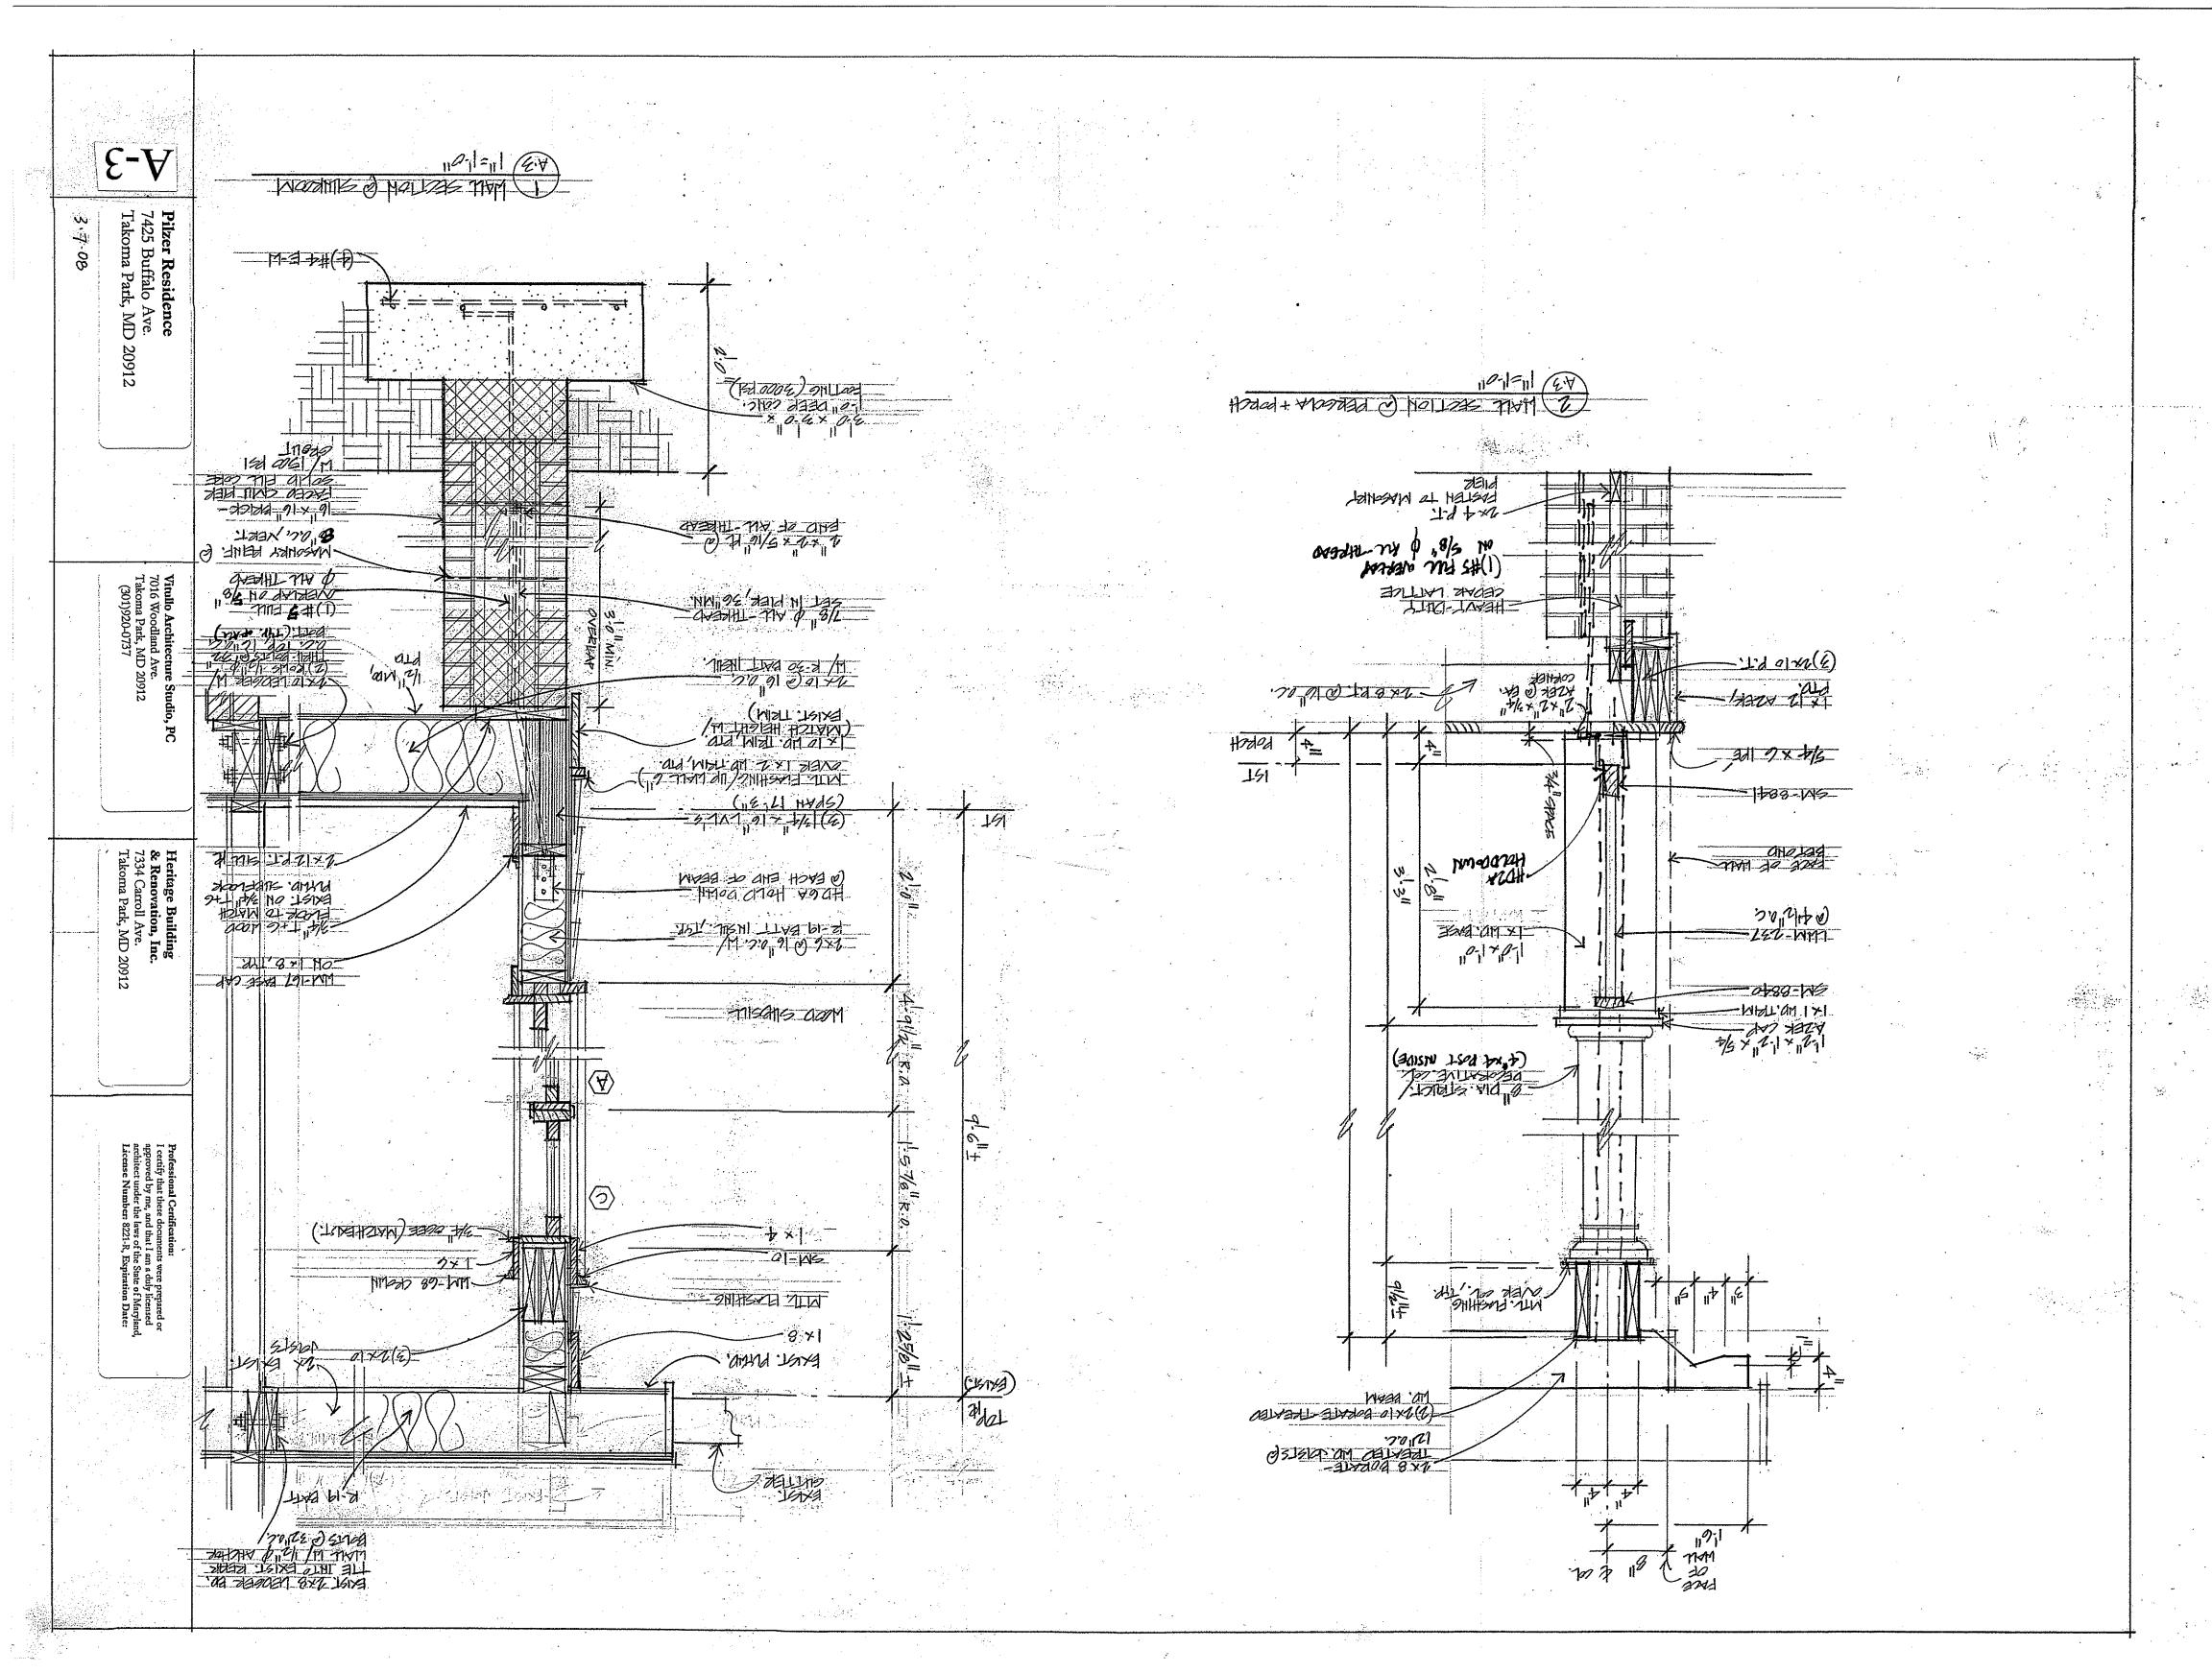

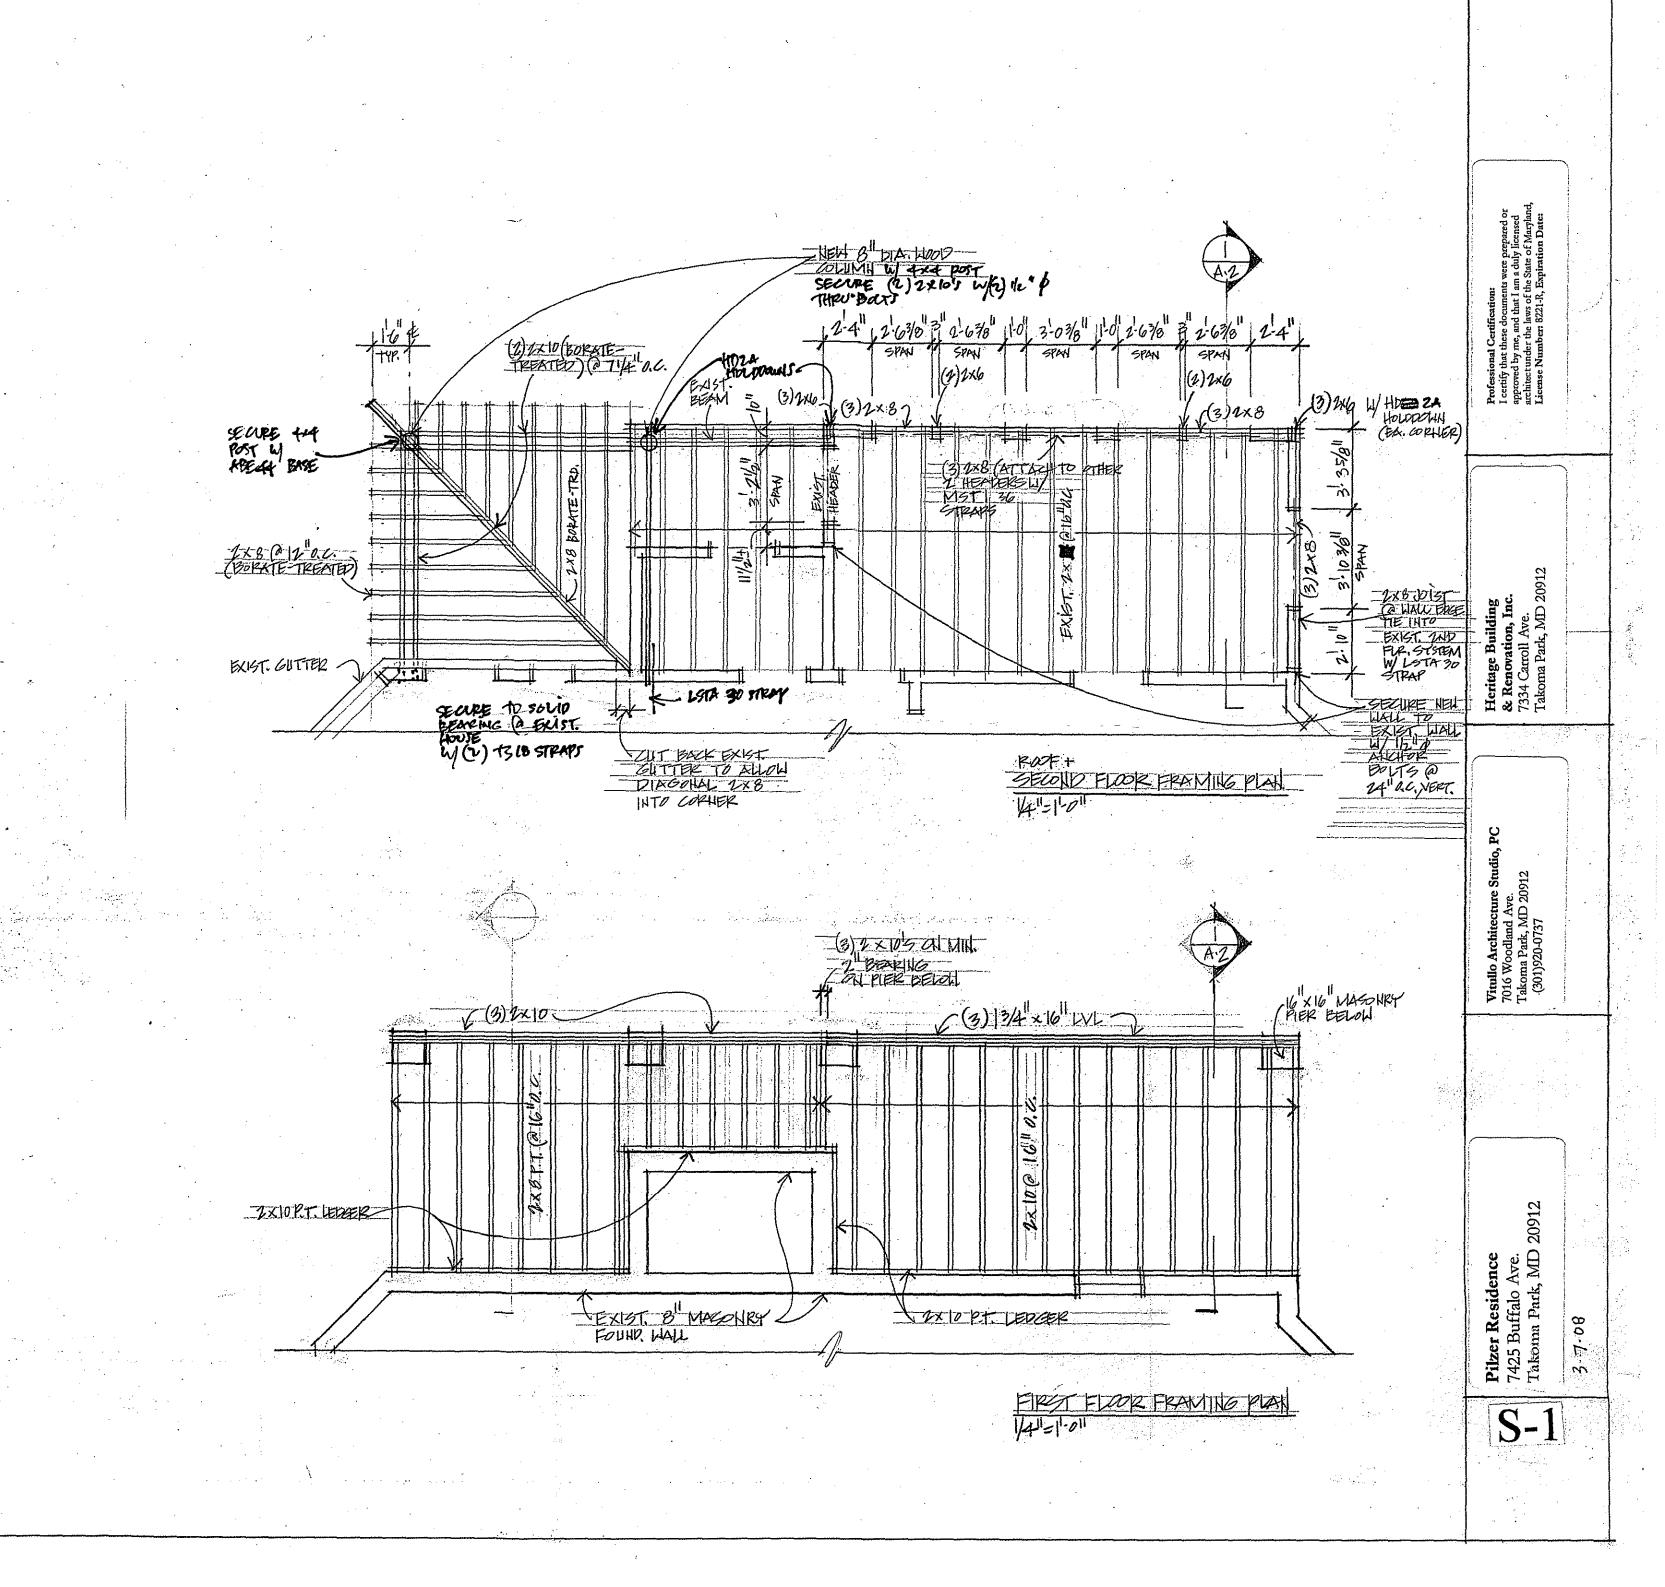



### HISTORIC PRESERVATION COMMISSION

Isiah Leggett County Executive Jef Fuller Chairperson

Date: 02/14/08

### **MEMORANDUM**

TO:

Carla Reid, Director

Department of Permitting Services

FROM:

Anne Fothergill

Planner Coordinator

Historic Preservation Section-Planning Department Maryland-National Capital Park & Planning Commission

SUBJECT:

Historic Area Work Permit #475923 - Rear siding /window replacement and rear porch

construction

The Montgomery County Historic Preservation Commission (HPC) has reviewed the attached application for a Historic Area Work Permit (HAWP). This application was **approved** at the February 13, 2008 meeting.

THE BUILDING PERMIT FOR THIS PROJECT SHALL BE ISSUED CONDITIONAL UPON ADHERENCE TO THE ABOVE APPROVED HAWP CONDITIONS AND MAY REQUIRE APPROVAL BY DPS OR ANOTHER LOCAL OFFICE BEFORE WORK CAN BEGIN.

Applicant:

Charles and Cecily Pilzer

Address:

7425 Buffalo Avenue, Takoma Park

This HAWP approval is subject to the general condition that the applicant will obtain all other applicable Montgomery County or local government agency permits. After the issuance of these permits, the applicant must contact this Historic Preservation Office if any changes to the approved plan are made.





Edit 6/21/99

DPS -#8

# HISTORIC PRESERVATION COMMISSION 301/563-3400

# APPLICATION FOR HISTORIC AREA WORK PERMIT

	1 /4		Contact Person: MUN VII	ou				
			Daytime Phone No.: (301) 92	0-0737				
Tex Account No.: 0107	1032							
Name of Property Owner:	•	y pilzer	Daytime Phone No.: (301) 565	. 8818				
	BUFFALO AL		OMA PARK	20912				
Street Number	ii -	City	Steel	Zip Code				
Contracton: HERITA	GE BUILDIN	16 + RENO	WHON Priorie No.: (301)270	· <del>4</del> 799				
Contractor Registration No.:		<del></del>	(- )	_		•	.e	
Agent for Owner: RICK	VITULIO		Daytime Phone No: (301) 92	0.0737				
LOCATION OF BUILDING/PA	MISE				•			
House Number: 7425		Street	BUFFALD AVE.					
lower City: TAKOMA	PARK	Nearest Cross Street	NEW YORK ME.					
Lot: PART OF Black;	75 Subdivisi	on: LOAN +	TRUST COG. SUBDIV.	OF TAKOMAPA	RK			
Liber: Folio:	Pe	celi .						
DADY DUE: TWO OF GENERAL	FACYION AND LICE				·		<b>K</b>	
PART ONE: TYPE OF PERMIT	ACTION AND USE	CHEPKA	LL APPLICABLE:					
1A. CHECK ALL APPLICABLE:  **Construct X Exten	4 di Attan Marinina	C) AC		arch X Deck 🗆 Shed			<i></i>	
			•			[3 [g]	15 11 11	12 13
			☐ Fireplace ☐ Woodburning Stove  //Ywil (complete Section 4) ☐ Other:	Single Family	121			
	7500-	· I_I Fance	Wall (complete Section 4) Ditier:		'	JAN	1 3 7 38	انا سیسیا
1C. If this is a revision of a previo		i gas Parinir W			27			
					DEPT	OF PES		TAVICE
PARTTWO: COMPLETE FOR	-1	AND EXTEND/ADDI	Tions		1. (L.)		raproperty strategy rapid. Propagation and	
2A. Type of sewage disposal:	01 Da Wesc	02 D Septic	63 🗆 Other:	**************************************				
28. Type of water supply:	01 Kwssc	02 🗀 Well	03 🖸 Other:					
PART THREE COMPLETE ON	VLY FOR FENCE/RETAIN	ING WALL			<b>.</b>			
3A. Heightfeet	inches			•				
3B. Indicate whether the lence	or retaining wall is to be or	enstructed on one of the	e following focations:	•				
On party line/property th	ne 🗆 Entirely o	n land of owner	On public right of way/easement					
	<del> </del>			<del>,</del>				
I hereby certify that I have the a	utharity to make the forego and I hereby acknowledge	ing application, that the and accept this to be a	application is correct and that the construct a condition for the issuance of this permit.	lion will comply with plans				
			,	,				
MA			1/14	08				
Signature a	l owner or authorized agent			Oele				
					•			
Approved:		For Cha	irperson, Historic Preservation Commission	214-08				
Disapproved:	\$ ignature:		Detta:	2714-00				
Application/Permit No.:	47592	Date	Filed: 16/08 Date (ssued)					

SEE REVERSE SIDE FOR INSTRUCTIONS

# THE FOLLOWING ITEMS MUST BE COMPLETED AND THE REQUIRED DOCUMENTS MUST ACCOMPANY THIS APPLICATION.

SUNRO	M ADDITIO	N IN BACK.	21000	TH CONTEMPORARY	
<del></del>	. '		<u> </u>		
		source(s), the environmental setting:	and, where applicable, the historic di	etrict:	FION
eral description of project	and its effect on the historic res	NON-CONFORMIN	G BEICK WHILL	BE SUNFOUND NOW	1 1-14
eral description of project REPURCH SINGUE	and its effect on the historic res EXISTING A GUAZE SLID	NON-CONFORMIN	MORE COMPAT	IBLE WOOD PRAME	uple.
erel description of project REPLACE SINGLE SILVAP	and its effect on the historic res EXISTING IN GUAZE SLID FIDING + DOC	NON-CONFORMIN ING DOPS WITH IBLE-HUNG WI	MORE COMPATIONS W/ TEA	PRE WOOD PRAME INFOMS.	upri

#### 2. SITE PLAN

Site and environmental setting, drawn to scale. You may us a your plat. Your site plan must include:

- a. the scale, north arrow, and date;
- b. dimensions of all existing and proposed structures; and
- c. site features such as walkways, driveways, fences, ponds, streams, trash dumpsters, mechanical equipment, and landscaping.

### 3. PLANS AND ELEVATIONS

You must submit 2 copies of plans and elevations in a format no larger than 11" x 17". Plans on 8 1/2" x 11" paper are preferred.

- Schematic construction plans, with marked dimensions, indicating location, size and general type of walls, window and door openings, and other fixed features of both the existing resource(s) and the proposed work.
- b. Elevations liacades), with marked dimensions, clearly indicating proposed work in relation to existing construction and, when appropriate, context.
  All malerials and fixtures proposed for the exterior must be noted on the elevations drawings. An existing and a proposed elevation drawing of each facade affected by the proposed work is required.

#### 4. MATERIALS SPECIFICATIONS

General description of materials and manufactured items proposed for incorporation in the work of the project. This information may be included on your design drawings.

### 5. PHOTOGRAPHS

- Clearly labeled photographic prints of each facade of existing resource, including details of the affected portions. All labels should be placed on the
  front of photographs.
- b. Clearly label photographic prints of the resource as viewed from the public right-of-way and of the adjoining properties. All labels should be placed on the front of photographs.


### 6. TREE SURVEY


If you are proposing construction adjacent to or within the credine of any tree 5° or larger in diameter (at approximately 4 feet above the ground), you must file an accurate tree survey identifying the size, location, and species of each tree of all least that dimension.

### 7. ADDRESSES OF ADJACENT AND CONFRONTING PROPERTY OWNERS

For ALL projects, provide an accurate list of adjacent and confronting property owners (not tenants), including names, addresses, and zip codes. This list should include the owners of all lots or parcels which adjoin the parcel in question, as well as the owner(s) of lat(s) or parcel(s) which lie directly across the street/highway from the parcel in question. You can obtain this information from the Department of Assessments and Taxation, 51 Monroe Street, Rockville, (301/279-1355).


PLEASE PRINT (IN BLUE OR BLACK INK) OR TYPE THIS INFORMATION ON THE FOLLOWING PAGE.
PLEASE STAY WITHIN THE GUIDES OF THE TEMPLATE. AS THIS WILL BE PHOTOCOPIED DIRECTLY ONTO MAILING LABELS.

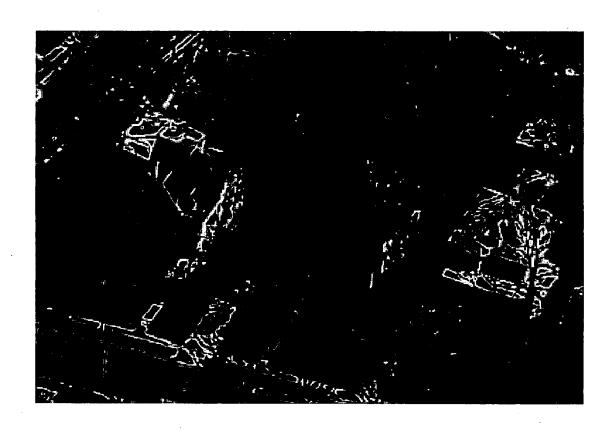


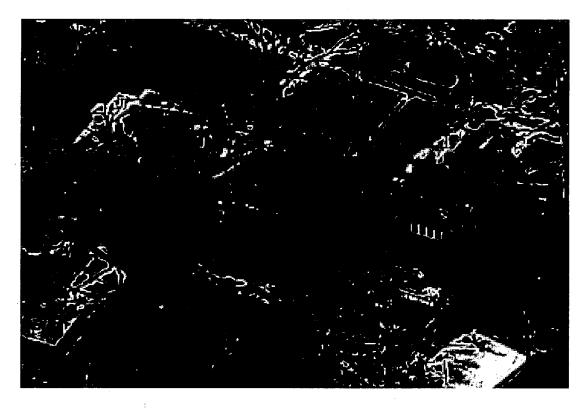







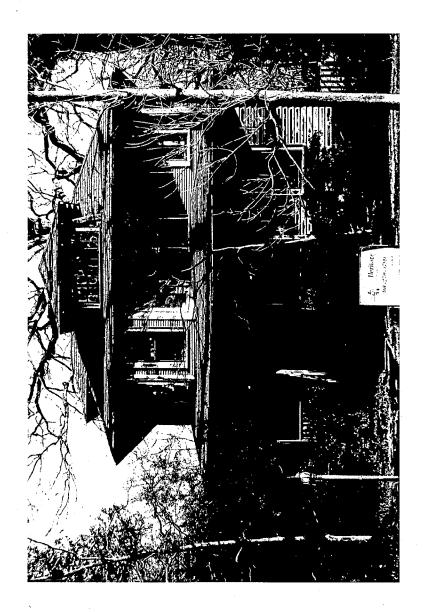

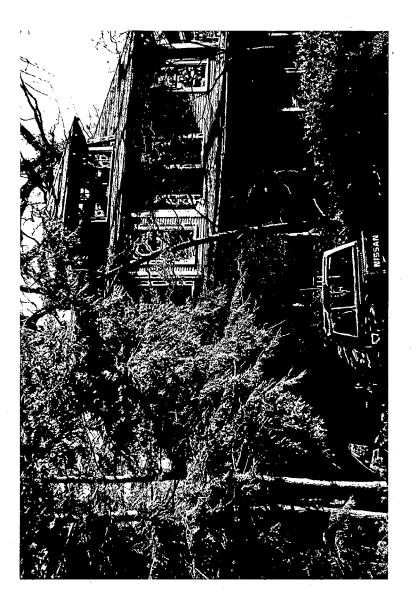

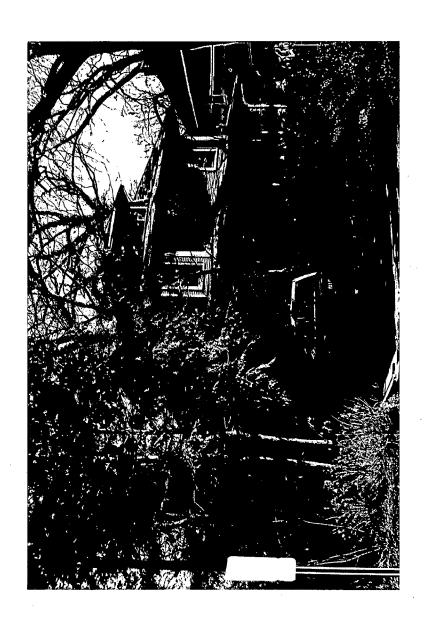



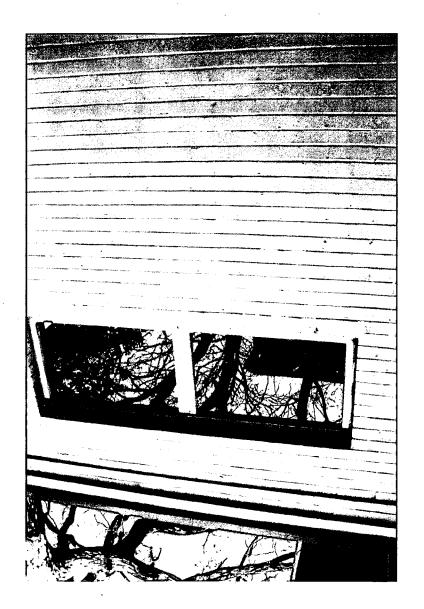



# MONTGOMERY COUNTY HISTORIC PRESERVATION COMMISSION STAFF REPORT

Address:

7425 Buffalo Avenue, Takoma Park

Meeting Date:

2/13/08

Resource:

Outstanding Resource

Report Date:

2/6/08

Resource:

T-1---- D. 1- Histonia D

Takoma Park Historic District

Public Notice:

1/30/08

Applicant:

Charles and Cecily Pilzer

(Rick Vitullo, Architect)

Tax Credit:

None

•

Review:

37/03-08E

**HAWP** 

Staff:

Anne Fothergill

PROPOSAL:

Case Number:

Rear siding and window replacement and rear porch construction

### STAFF RECOMMENDATION

Staff is recommending that the HPC approve this HAWP application.

### ARCHITECTURAL DESCRIPTION

SIGNIFICANCE:

Outstanding Resource within the Takoma Park Historic District

STYLE:

Craftsman Four Square

DATE:

1918

#### **PROPOSAL**

The applicants are proposing changes to the existing non-historic rear sunroom including a change from brick to Hardie Plank siding, new brick piers with wood lattice, and new wood windows. They are also proposing new wood casement windows on the 2<sup>nd</sup> floor rear elevation where there are currently non-original metal sliding glass doors. At the far left side of the house they are proposing to extend an open porch with wood columns and balustrade across the back and connecting to a non-original bay. A rear porch was approved by the HPC in 1992 (the back door is already in place) and this proposal is essentially the same and in the same location.

The applicants have consulted with the City arborist on a tree protection plan and tree protection measures will be in place prior to construction.

### **APPLICABLE GUIDELINES**

When reviewing alterations and new construction within the Takoma Park Historic District several documents are to be utilized as guidelines to assist the Commission in developing their decision. These documents include the historic preservation review guidelines in the approved and adopted amendment for the Takoma Park Historic District (Guidelines), Montgomery County Code Chapter 24A (Chapter 24A), and the Secretary of the Interior's Standards for Rehabilitation (Standards). The pertinent information in these documents is outlined below.

#### Takoma Park Historic District

The Guidelines define Outstanding Resources as:

A resource which is of outstanding significance due to its architectural and/or historical features. An outstanding resource may date from any historical period and may be representative of any architectural style. However, it must have special features, architectural details and/or historical associations that make the resource especially important to the history of the district, and/or it must be especially unique within the context of the district.

The following Takoma Park Guidelines pertain to this project:

- plans for all alterations should be compatible with the resource's original design; additions, specifically, should be sympathetic to existing architectural character, including massing, height, setbacks and materials.
- emphasize placement of major additions to the rear of the existing structures so that they are less visible from the public right-of-way.
- while additions should be compatible, they are not required to be replicative of earlier architectural styles.
- preservation of original and distinctive architectural features, such as porch dormers, decorative details, shutters etc. is encouraged.
- preservation of original windows and doors, particularly those with specific architectural importance, and of original size and shape of openings is encouraged.
- preservation of original building materials and use of appropriate, compatible new materials is encouraged.

### Montgomery County Code; Chapter 24A

A HAWP permit should be issued if the Commission finds that:

- 1. The proposal will not substantially alter the exterior features of a historic site or historic resource within a historic district.
- 2. The proposal is compatible in character and nature with the historical archaeological, architectural or cultural features of the historic site or the historic district in which a historic resource is located and would not be detrimental thereto of to the achievement of the purposes of this chapter.

In the case of an application for work on a historic resource located within a historic district, the Commission shall be lenient in its judgment of plans for structures of little historical or design significance or for plans involving new construction, unless such plans would seriously impair the historic or architectural value surrounding historic resources or would impair the character of the historic district.

### Secretary of the Interior's Standards for Rehabilitation:

# 9: New additions, exterior alterations, or related new construction will not destroy historic materials, features, and spatial relationships that characterize the property. The new work shall be differentiated from the old and will be compatible with the historic materials, features, size, scale and proportion, and massing to protect the integrity of the property and its environment.

# 10: New additions and adjacent or related new construction will be undertaken in such a manner that, if removed in the future, the essential form and integrity of the historic property and its environment would be unimpaired.

### STAFF DISCUSSION

This house is an Outstanding Resource and it is important to ensure that any proposed alterations and additions are appropriate and compatible with the house. The proposed changes are all at the rear of the house and will not adversely impact the resource or the historic district. Staff recommends approval of this application.

### **STAFF RECOMMENDATION**

Staff recommends that the Commission approve the HAWP application as being consistent with Chapter 24A-8(b)(1) & (2);

and with the Secretary of the Interior's Standards for Rehabilitation;

and with the general condition that the applicant shall present the 3 permit sets of drawings, if applicable, to Historic Preservation Commission (HPC) staff for review and stamping prior to submission for the Montgomery County Department of Permitting Services (DPS) building permits;

and with the general condition that the applicant shall notify the Historic Preservation Staff if they propose to make any alterations to the approved plans.