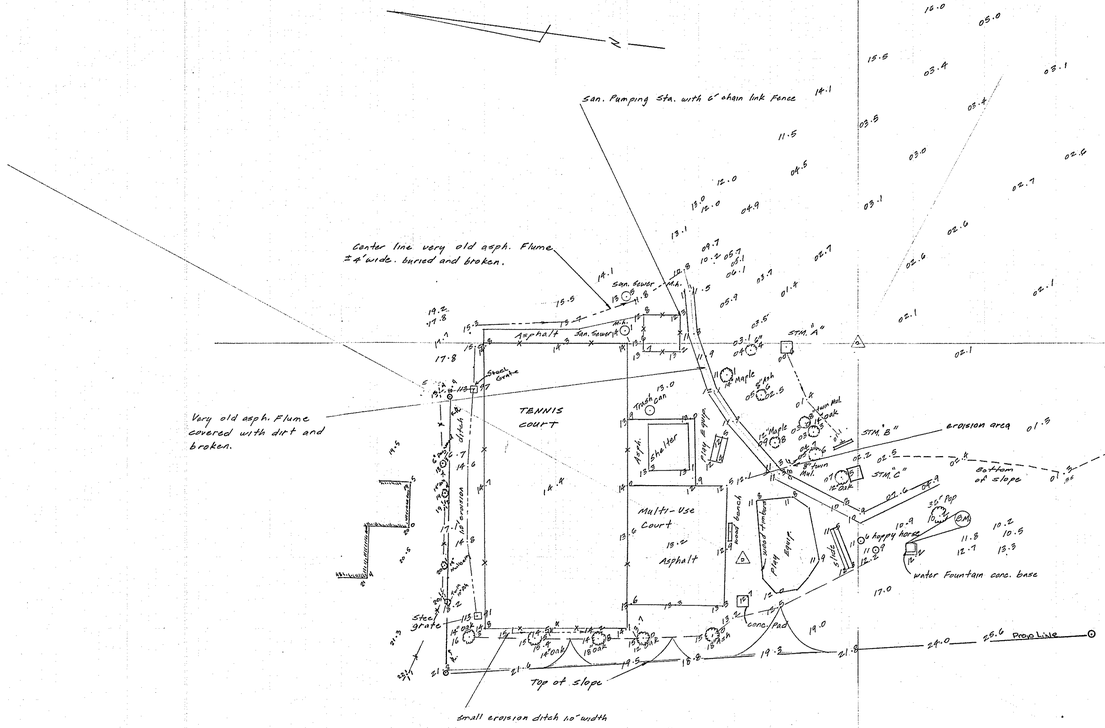

STM. Box "A" Top of grate el. 101.90' Invert 15" in El. 100.20
15" out El. 100.00

STM Box "B" Top of conc. Headwall El. 104.30'
Inv. 18" RCP. EL. 101.00'

STM Box "C" Top of conc. box El. 103.40 throat El. 102.2
invert 15" R.C.P. El. 100.0 IN
invert 18" R.C.P. El. 100.6 IN
invert 15" R.C.P. El. 99.9 OUT

B.M. square cut in N. W. corn. of conc. water Fountain
Elev. 112.03'

BROOKMONT PARK
TOPOGRAPIC SURVEY
SCALE: 1" = 30'
DATE: NOVEMBER 19, 1990

Brookmont 11-90