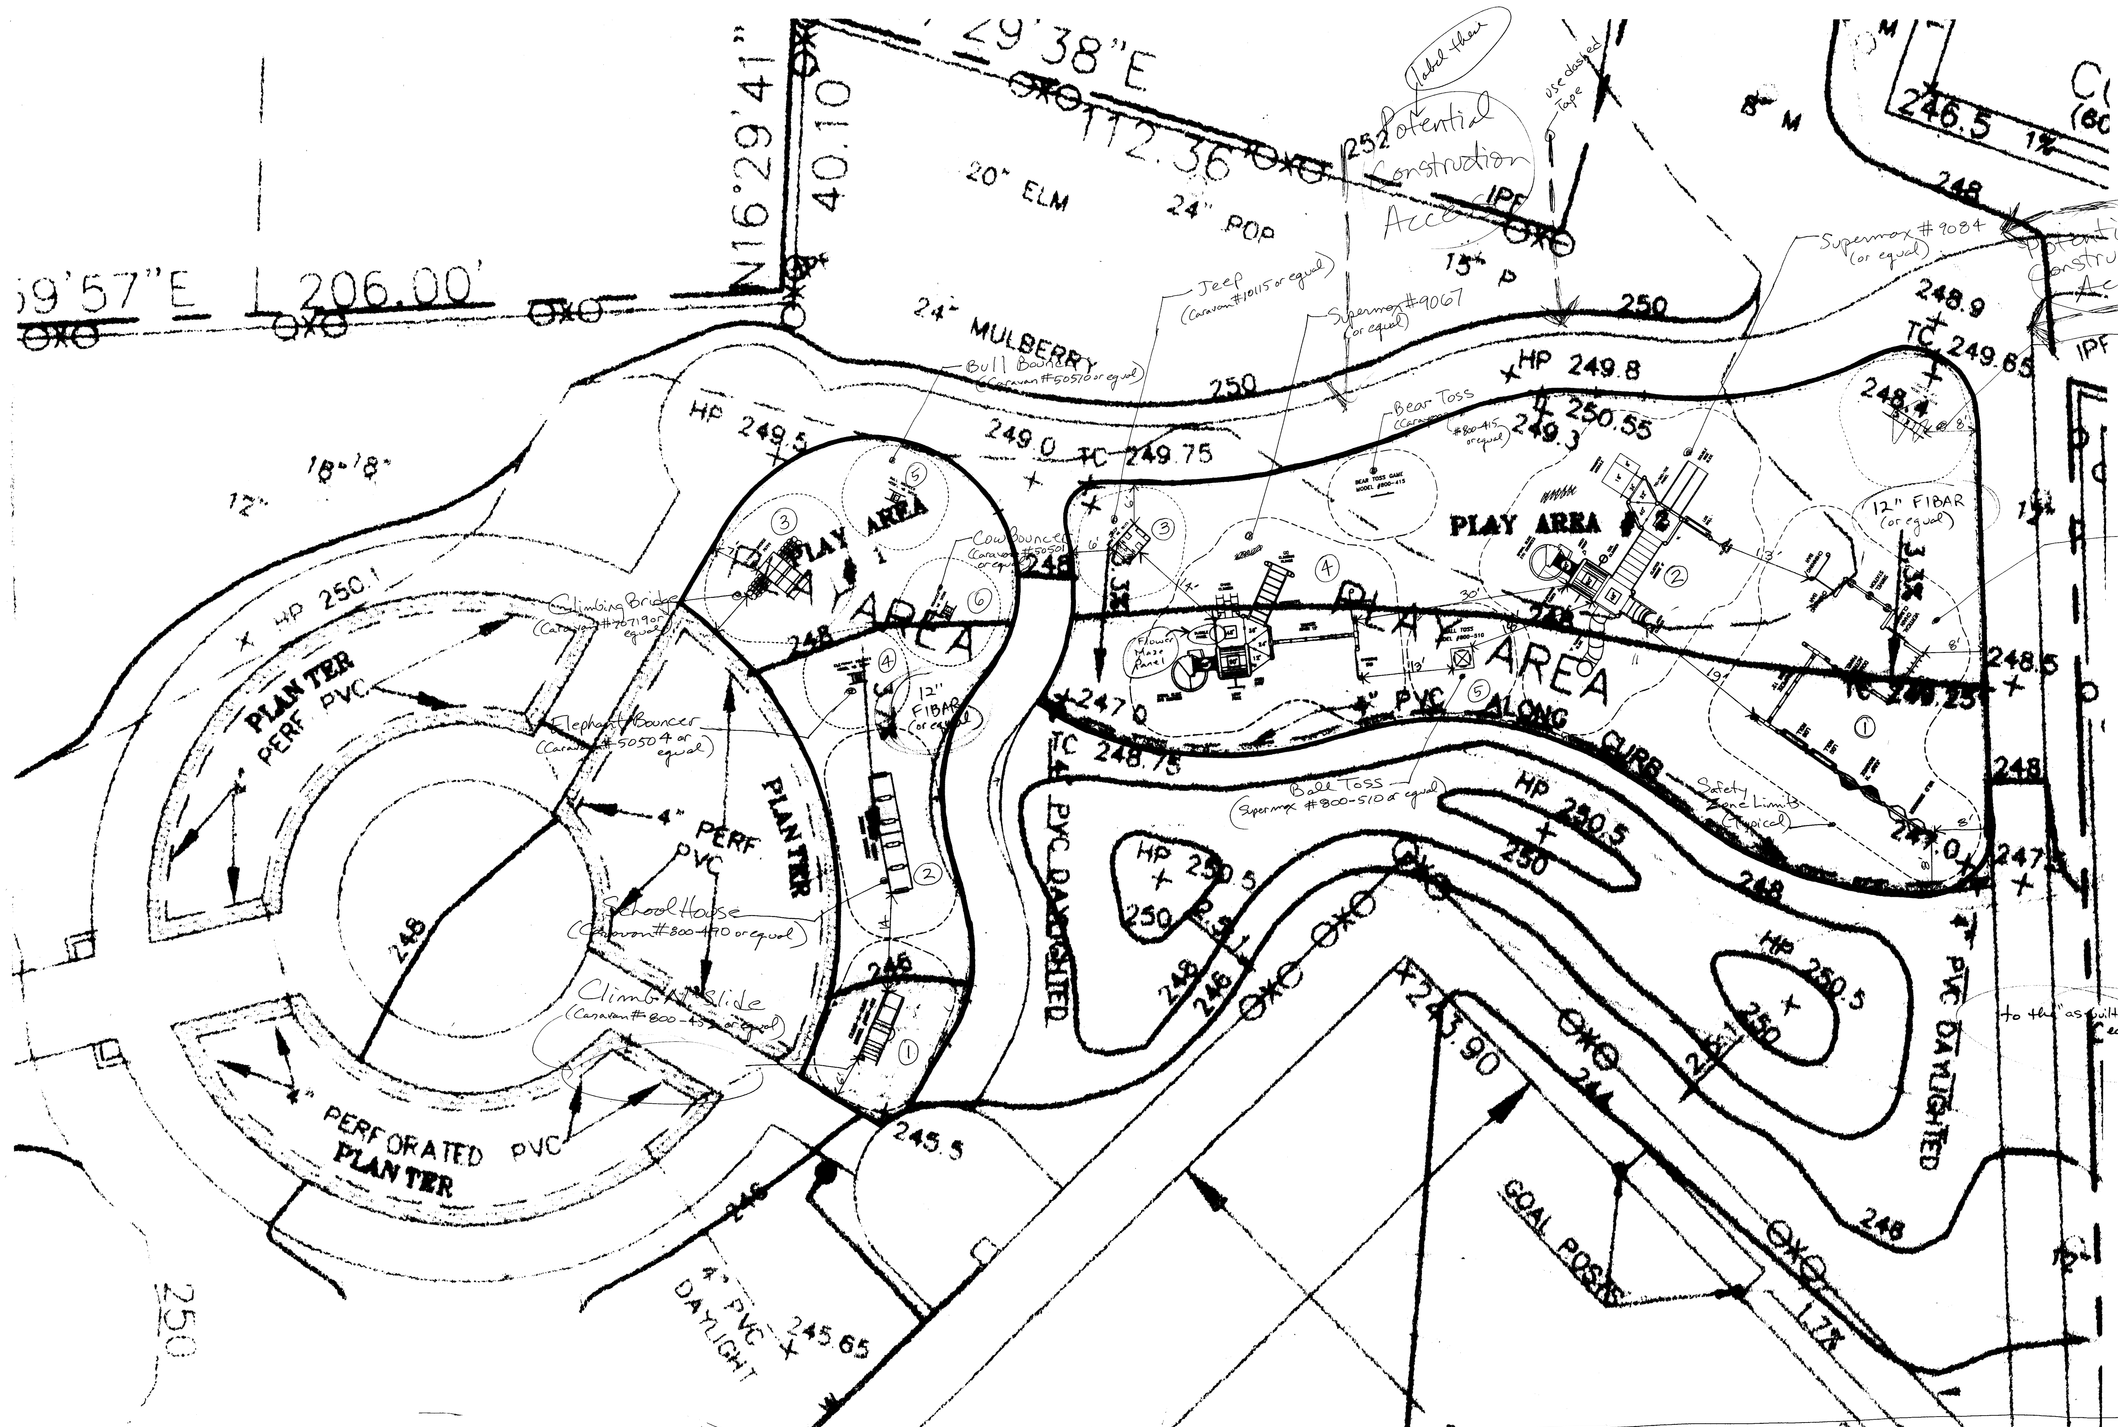

29'38"E
112.36'
N16°29'41"
40.10
59'57"E
206.00'
20" ELM
24" POP
24" MULBERRY
Potential Construction Access
Label these
use dashed Tape
Jeep (Caravan #10115 or equal)
Supermax #9067 (or equal)
Supermax #9084 (or equal)
Bull Bouncer (Caravan #50570 or equal)
Bear Toss (Caravan #800-415 or equal)
Cow Bouncer (Caravan #50501 or equal)
Climbing Bridge (Caravan #70719 or equal)
Elephant Bouncer (Caravan #50504 or equal)
School House (Caravan #800-490 or equal)
Climb N Slide (Caravan #800-432 or equal)
Ball Toss (Supermax #800-510 or equal)
Safety Zone Limits (Typical)
Flower Maze Panel
PLAY AREA #1
PLAY AREA #2
PLAY AREA
PLANTER
PERF PVC
4" PERF PVC
PERFORATED PVC
4" PVC DAYLIGHT
4" PVC ALONG CURB
GOAL POSTS
12" FIBAR (or equal)
Potential Construction Access
CROY These Equipment Titles
Airplane (Caravan #10118 or equal)
No Deck Activity Cluster (Supermax #800-820 or equal)
Erase everything in yellow (from the back = a reverse read)
Note: Equipment Stakeout shall be completed according to the designated order: ①②③... utilizing provided clear dimensions to the "as built" edging and fully maintaining the minimum safety zone as illustrated.
SCANNED
Shift Drawing when you cut it to 24" x 36" to allow title block to fit
Scale: 1"=10'
Add standard Title Block AND PAGE BORDER
New Hampshire Estates Neighborhood Park
Play Equipment Installation
Reminder: label by hand "Flower Maze Panel" & remove "Bubble Panel"