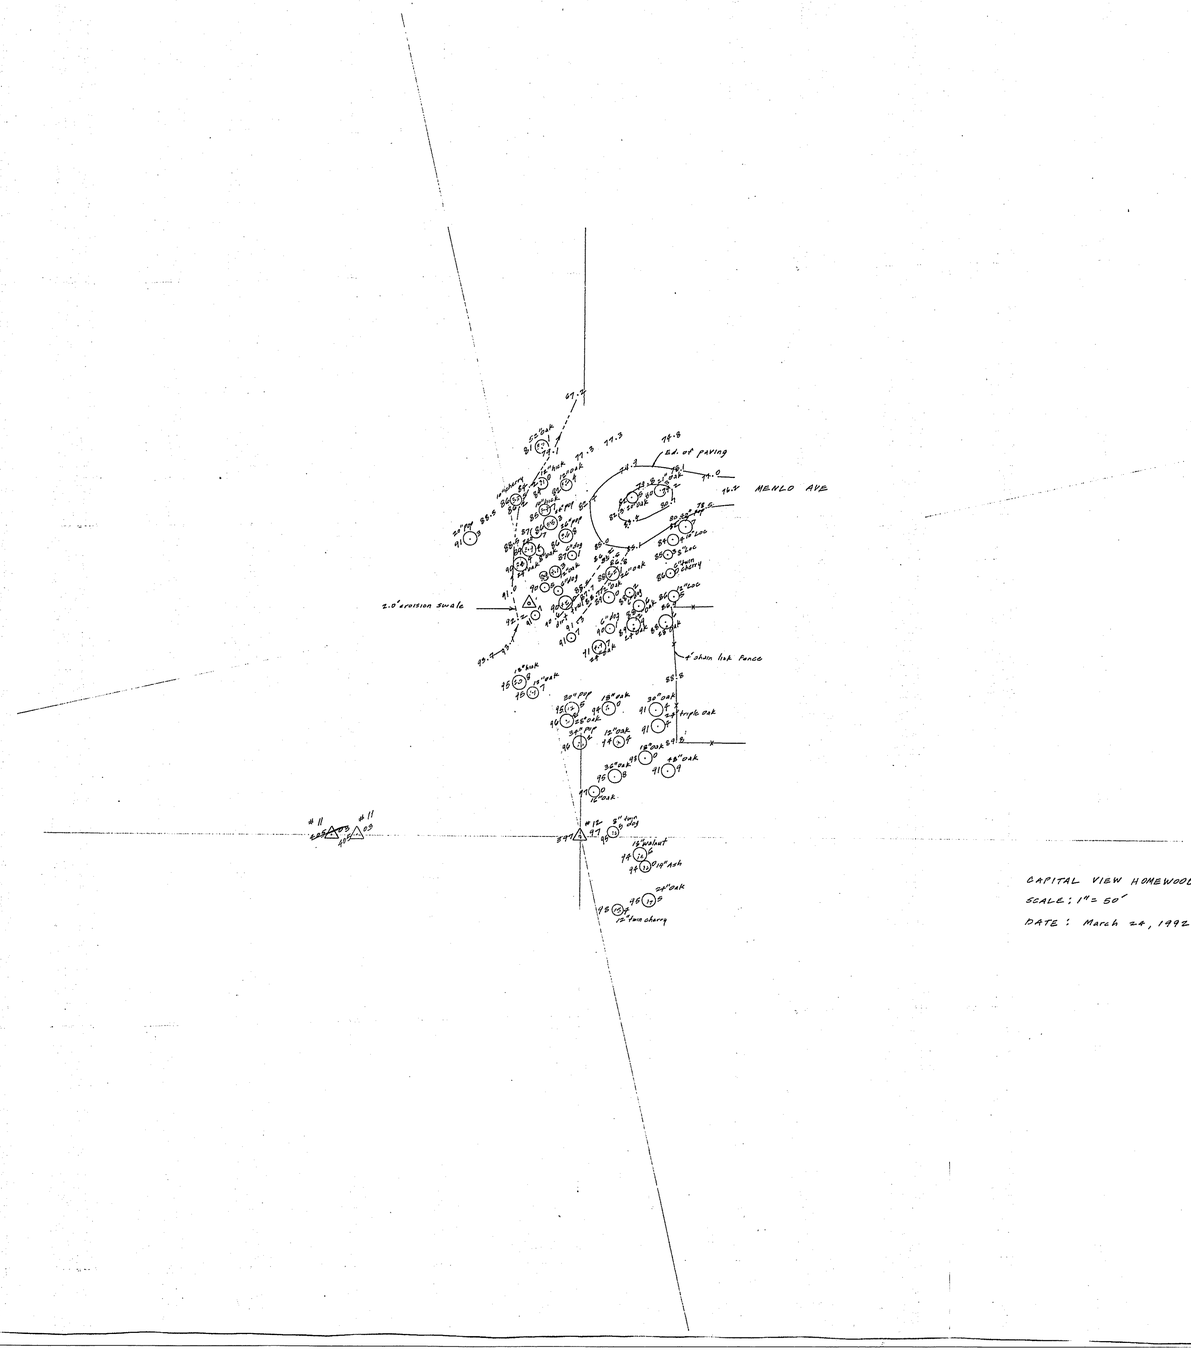

CAPITAL VIEW HOMEWOOD

SCALE: 1" = 50'

DATE: March 24, 1992