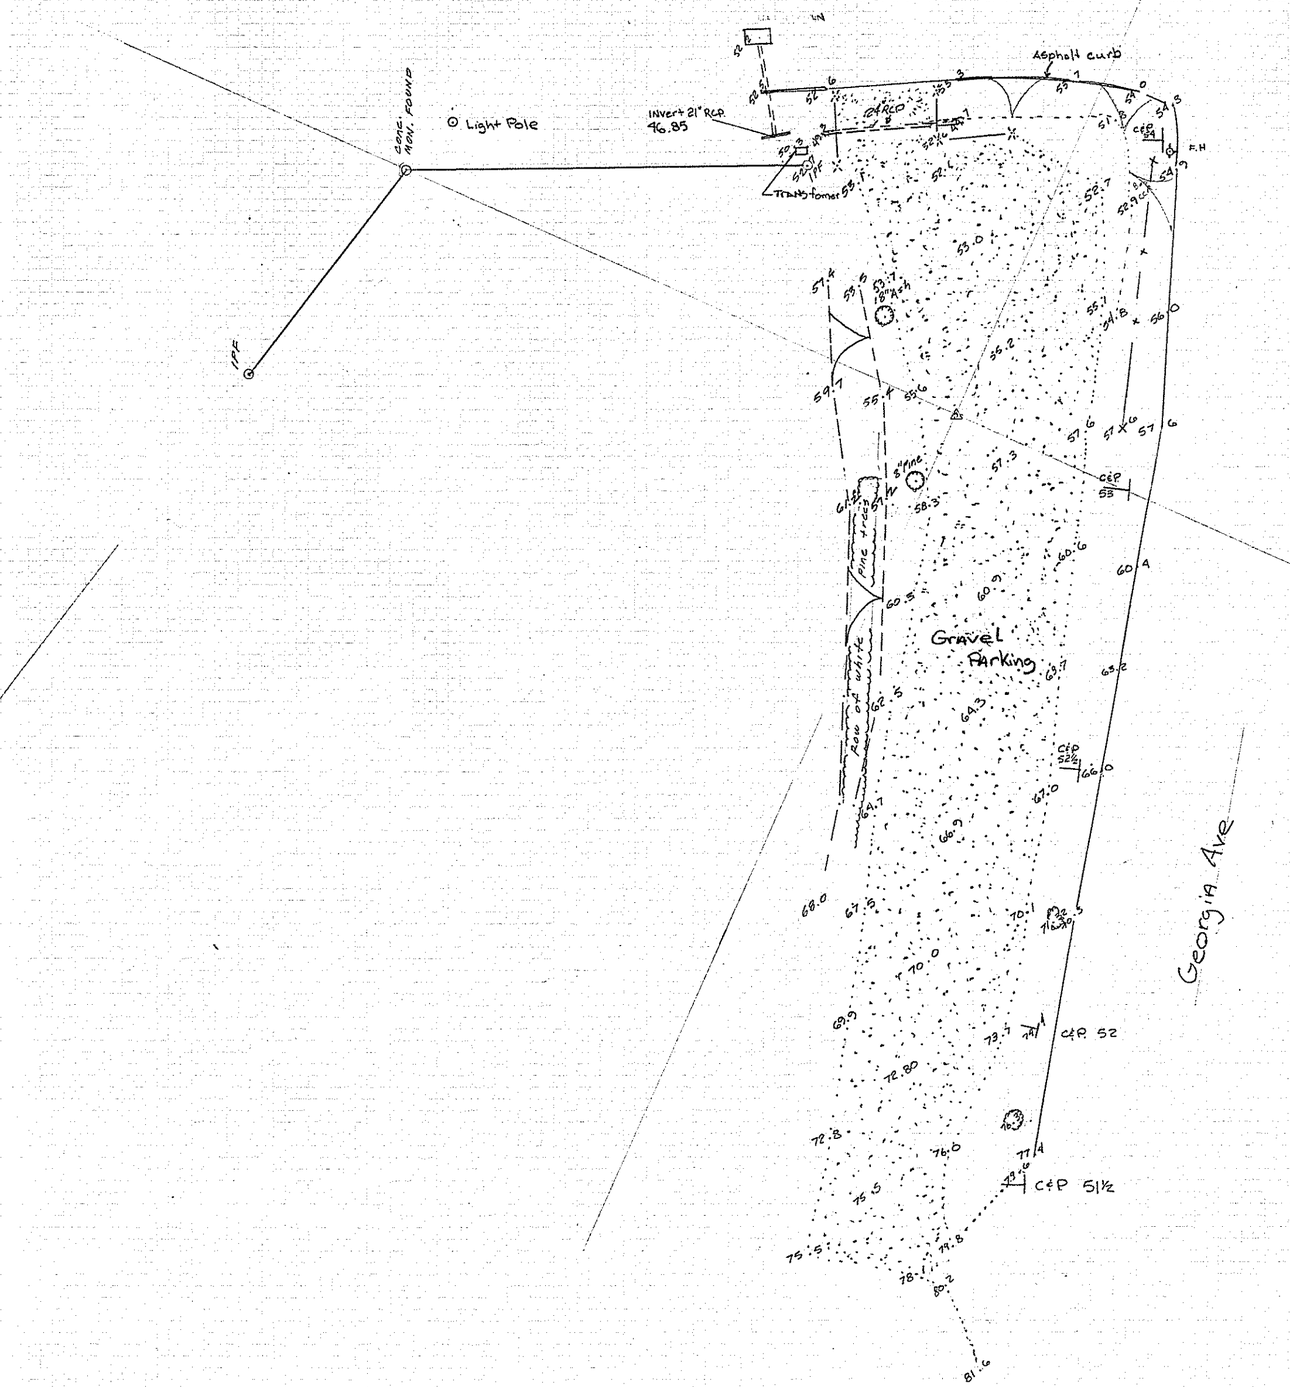

LONGWOOD LOCAL PARK

ADD TOPO 1-03-91 M.L.-M.M.-M.S.

SCALE 1"=50'