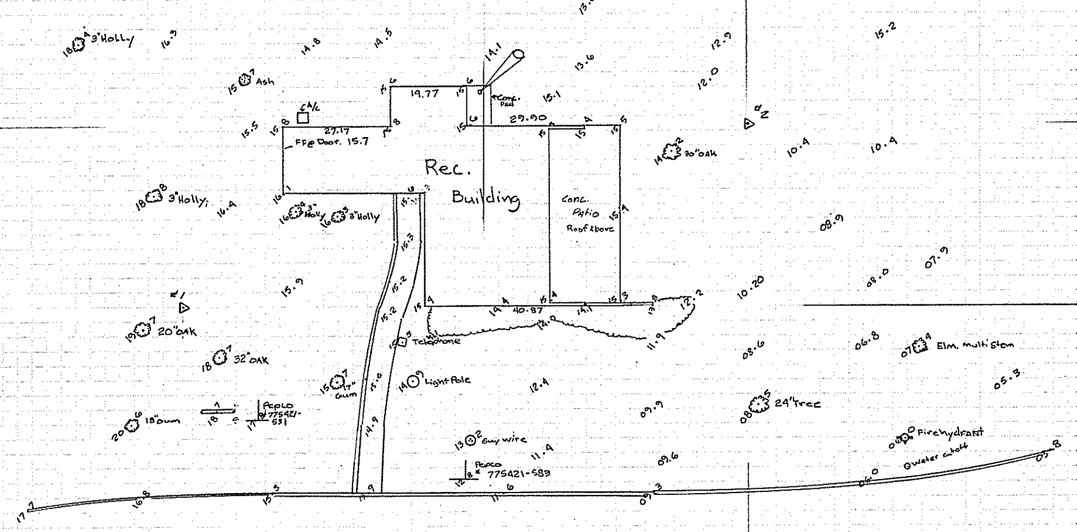

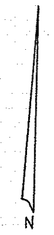

Lynnbrook Local Park

Scale 1"=30' 01-21-92 P.S.M.L.M.S.