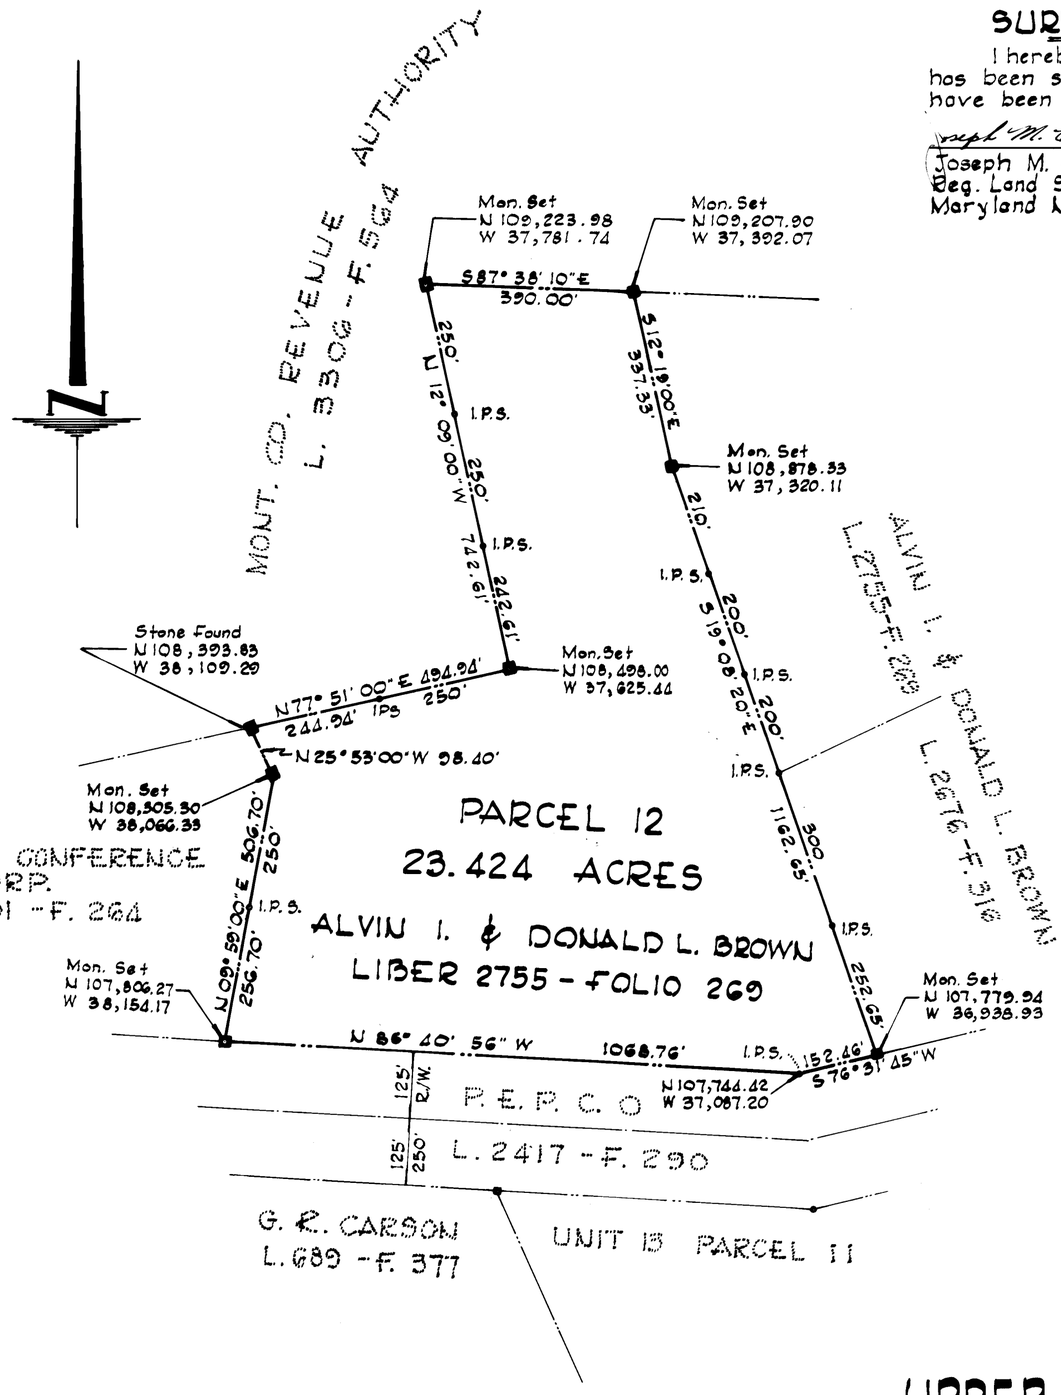

SURVEYOR'S CERTIFICATE

I hereby certify that the property shown hereon has been surveyed and that property markers have been found or set as indicated.

Joseph M. Cutsail, Jr.

Joseph M. Cutsail, Jr.
Reg. Land Surveyor
Maryland No. 3624

SCALE

PLAT OF SURVEY
PARCEL 12
~~UPPER ROCK CREEK WATERSHED~~
~~UNIT 13~~

MONTGOMERY COUNTY, MARYLAND

SCALE: 1" = 200' MARCH 1965

AGRICULTURAL HISTORY FARM

SPECIAL PARK

DEPARTMENT OF PARKS
MARYLAND NATIONAL CAPITOL PARK & PLANNING COMMISSION

MATZ, CHILDS & ASSOCIATES
CIVIL ENGINEERS - LAND SURVEYORS
322 NORTH STONESTREET AVE.
ROCKVILLE, MARYLAND
PO 2-5533

~~UNIT 13~~ PARCEL 12

64-080R